


**CLAIM OF BENEFICIAL USE SURVEY R-15343
T37S R06W SECTION 14; TAXLOT 1001
ROGUE RIVER BASIN- JOSEPHINE COUNTY, OR**

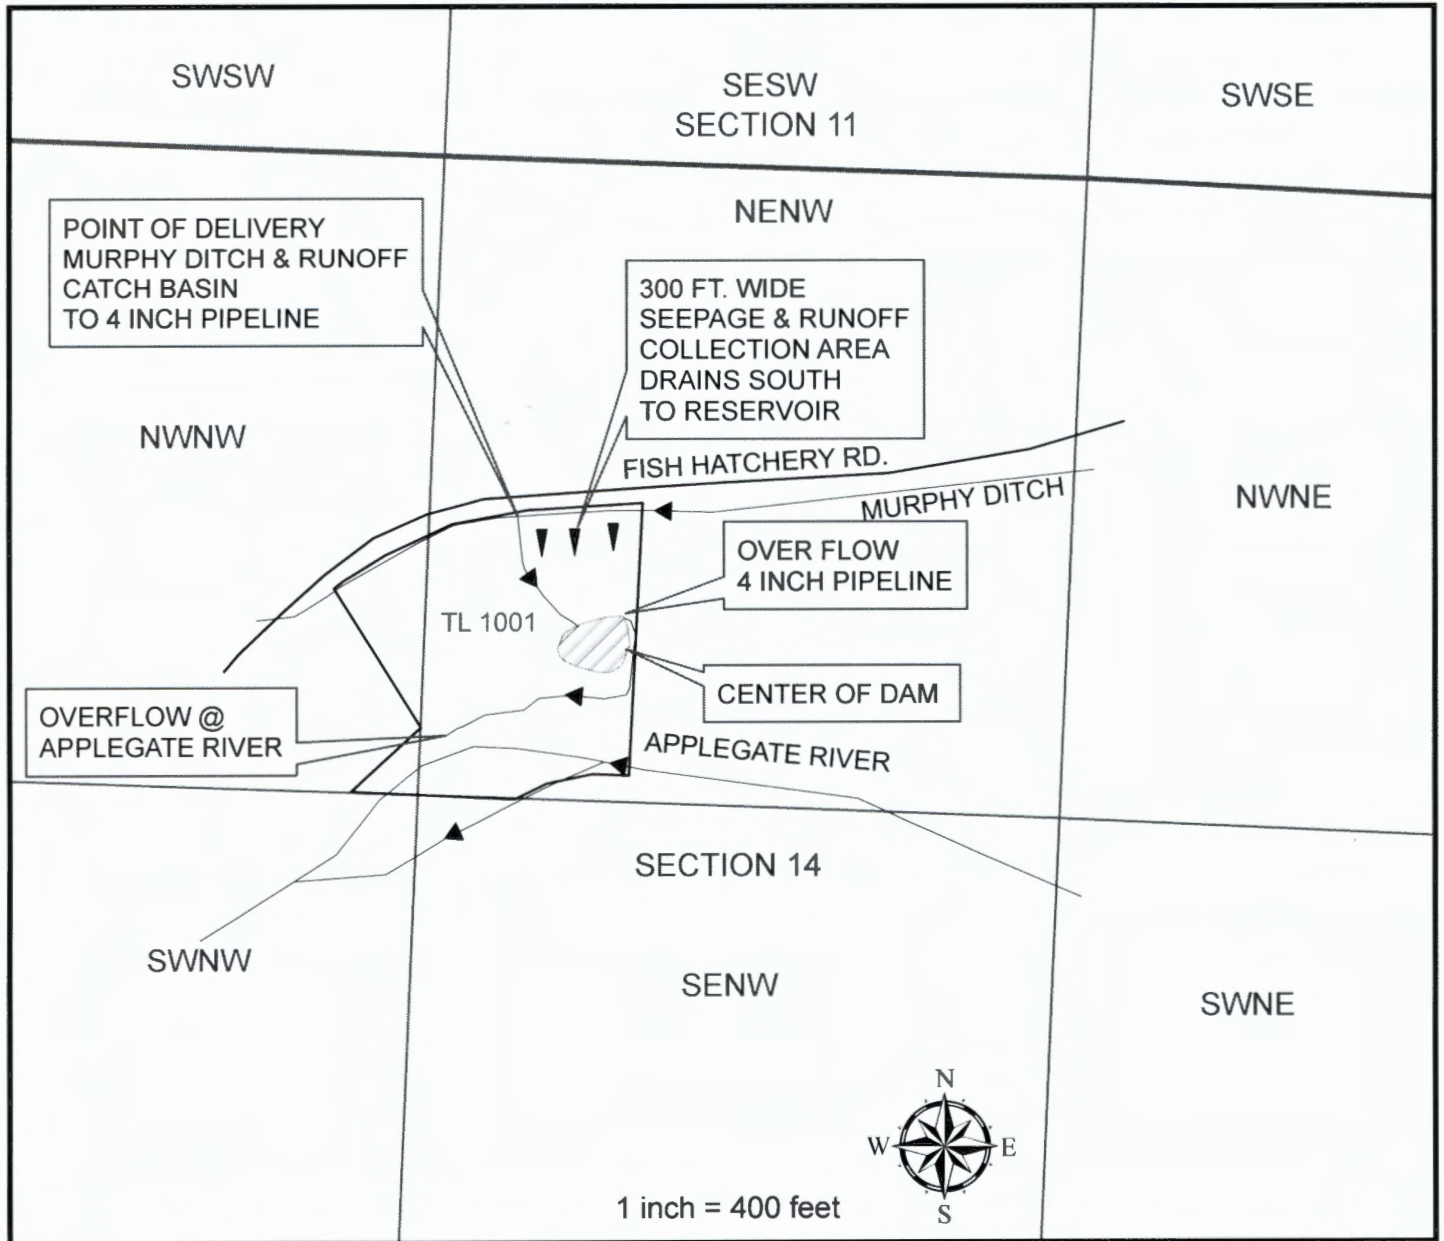

RESERVOIR
AREA: 13,100 SQ. FT. (0.30 ACRES)
AVERAGE DEPTH: 2.5 FT.
CAPACITY: 0.75 ACRE FEET

DAM LOCATION
LAT 42-21-31.80685
LON -123-22-49.08416

MURPHY DITCH POINT OF DELIVERY
LAT 42-21-34.38618
LON -123-22-52.22593
RUNOFF & SEEPAGE DIVERSION
FROM 0 TO 300 FEET EASTERLY



PREPARED FOR:
William & Janice Worhman
969 Fish Hatchery Rd.
Grants Pass, OR 97527

PREPARED BY:
Scott Fein Water Rights
600 Tyler Creek Rd.
Ashland, OR 97520
sfeinsurveyor@gmail.com
541-842-0795

RECEIVED

DEC 18 2019

OWRD

*For water rights
purposes only
Not for property boundary
dimensions or locations*