



RENEWAL DATE 12/31/2021

- Well
- Meter
- Pipeline
- ▨ POU NU
- Section
- Quarter Quarter
- Tax Lot


RECEIVED

MAY 13 2020

OWRD




T1S R4E, WM
CLACKAMAS COUNTY, OR

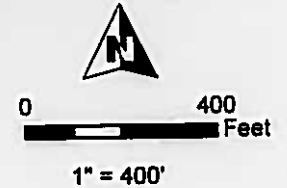

Well Location:

Well #2 (L-116771): 340' S, 370' E of NW Cor Sec 32

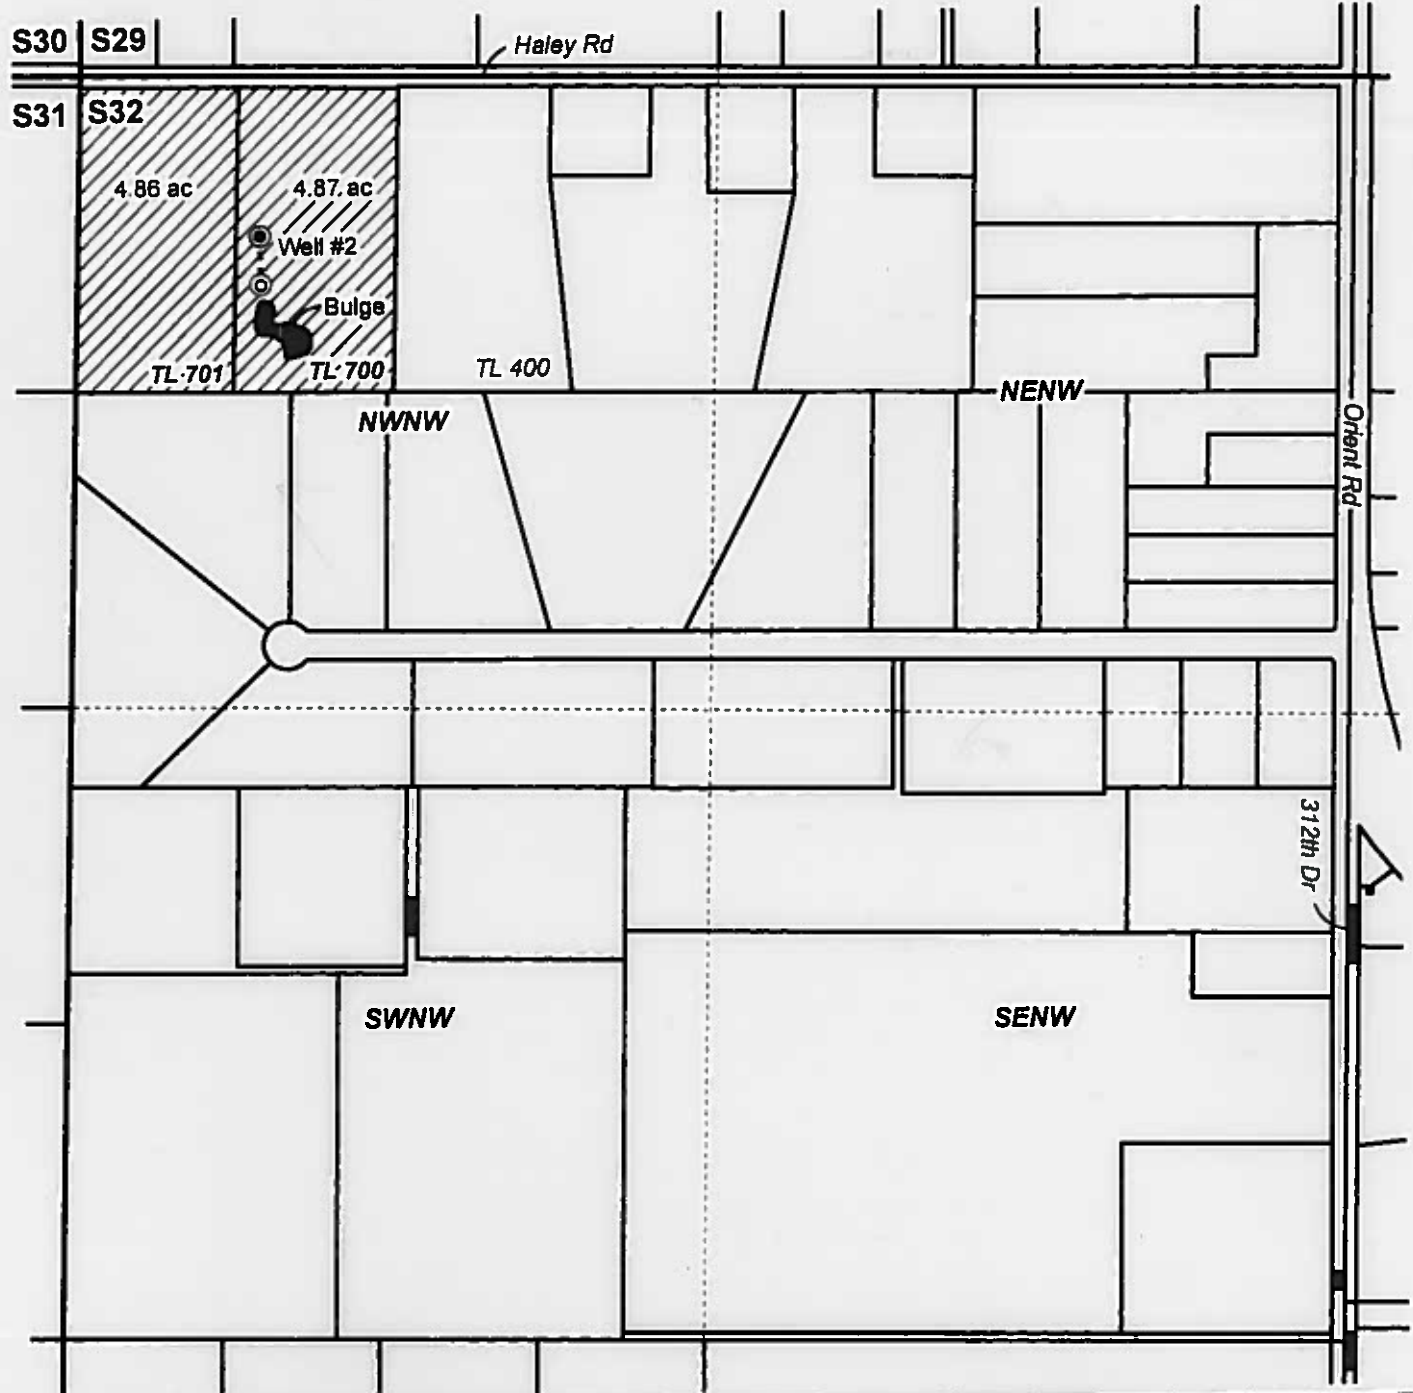

CLAIM OF BENEFICIAL USE MAP
Michael & Cheryl Bratcher

This map is not intended
to provide legal dimensions
or locations of property

WATER RIGHT SERVICES, LLC
PO BOX 1830, BEND, OR 97709
WWW.OREGONWATER.US CCB # 197121
info@wrservices.com 541-389-2837