

Claim of Beneficial Use


APPLICATION S-86296

PERMIT S-54259


TOWNSHIP 26 S., RANGE 5 W., W.M. - SECTION 26

DOUGLAS COUNTY, OREGON

Assessor Map # T-26S, R5W-26 BA

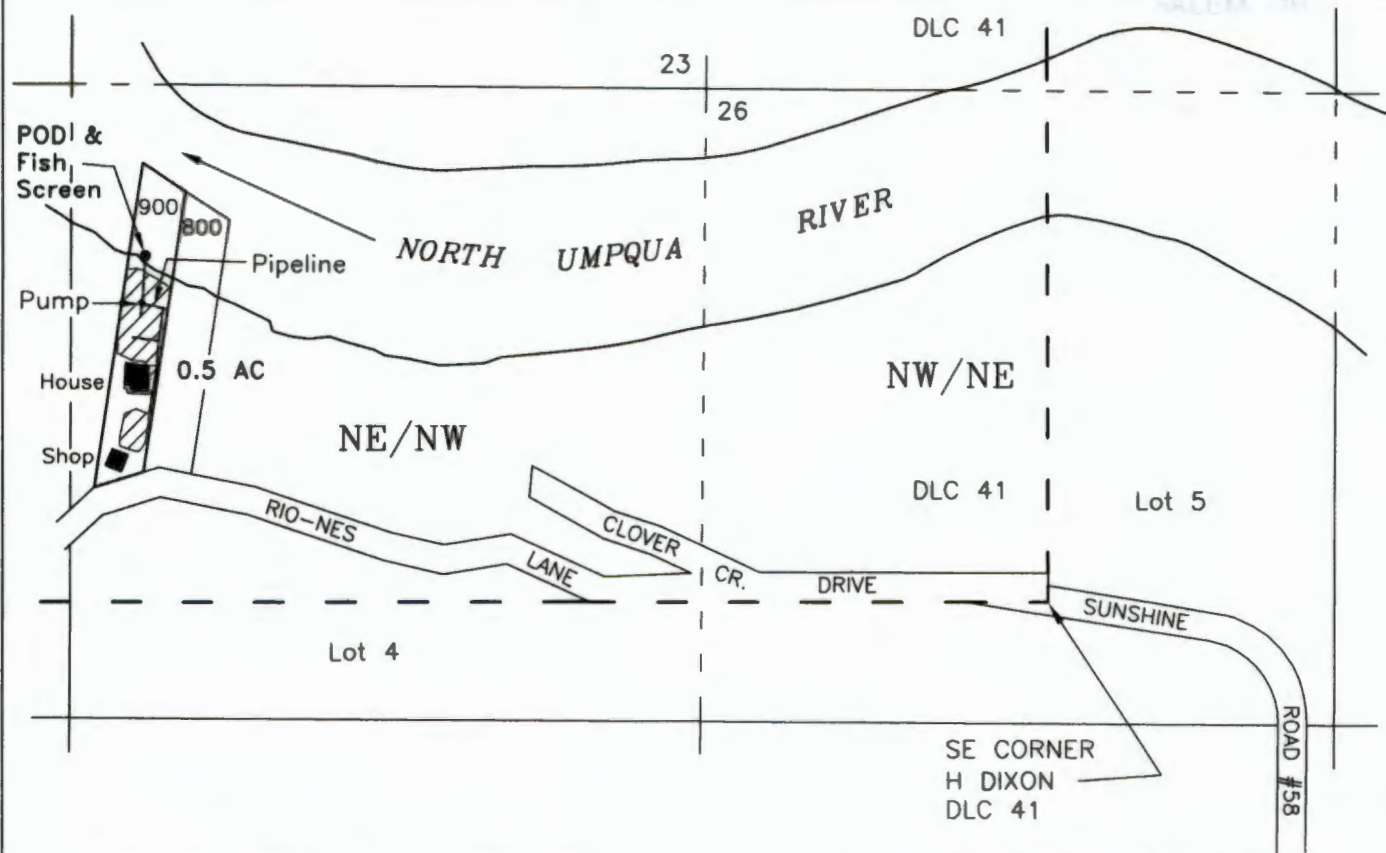


POD - Section 26 NE/NW, DLC 41, 725 feet North & 1880 feet West from the SE corner DLC 41

- - - DLC Line
-  Irrigation of 0.5 Acres

Wayne J. & Judith A. Robinson
345 Rio-Ness Lane
Roseburg, OR 97470

Scale
1" = 400'

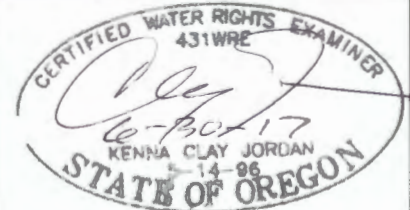

JORDAN ENGINEERING
460 JORDAN LANE
ROSEBURG, OREGON 97471
(541) 673-1931

Base map - Recorded Survey's CS 42-182 & CS 51-159 over 10/19/2016 Oregon Map Aerial Photo for assumed best fit

This map is not intended to provide legal dimensions or locations of property ownership lines

10-19-2016 n.e.d.