



MAP TO ACCOMPANY CLAIM OF BENEFICIAL USE
 LOCATED IN THE NE1/4 OF THE SW1/4 OF SECTION 22,
 T10S, R23E, W.M., WHEELER COUNTY, OREGON
 TAX LOT: 10-23-0000-00500

APPLICATION NO. R-88176
 PERMIT NO. R-15167

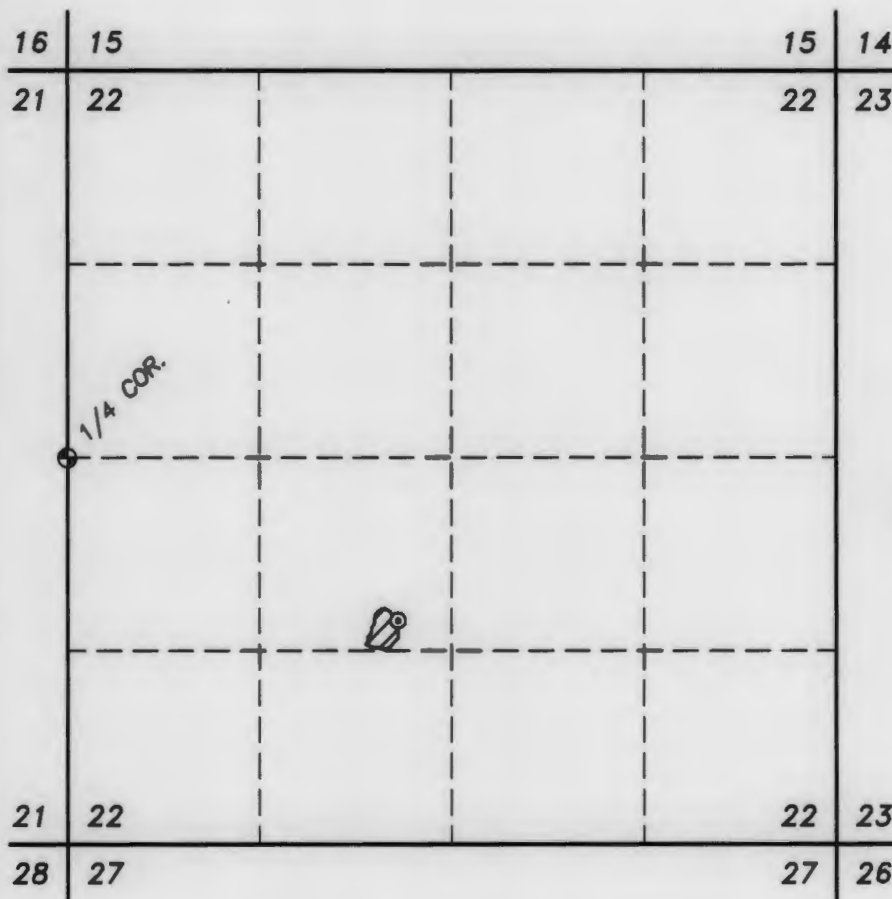

SCALE 1" = 1320'

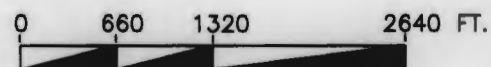

RECEIVED

JUL 23 2018

OWRD

LEGEND


— SECTION LINE

- - - 1/4, 1/4 SECTION LINE

⊙ DAM - 2270 FT. EAST AND 1110 FT. SOUTH
 OF WEST 1/4 CORNER SECTION 22
 LAT. N 44°41'06.6" LONG. W 119°57'02.7"
 (WGS84 DATUM)

▨ AREA SUBMERGED BY EXISTING RESERVOIR.
 0.936 ACRES (±4.02 ACRE FEET).

NOTE: PREPARATION OF THIS MAP IS FOR PURPOSES
 OF IDENTIFYING PROPOSED WATER RIGHTS ONLY. IT
 HAS NO INTENT TO PROVIDE LOCATIONS OR DIMENSIONS
 OF PROPERTY BOUNDARIES.

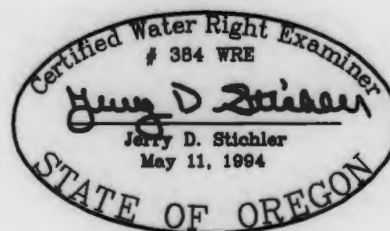

06/29/18

RENEWAL 6/30/20

PERMIT HOLDER:
 SIX SHOOTER RANCH, LLC
 2357 HILLSIDE ROAD
 RICHFIELD, WISCONSIN 53076
 JUNE 5, 2018 SHEET 1 OF 1

DRAWN BY: J.S.

ACAD: 1761_FP1