


T.6S. R.2W. Section 16, W.M.

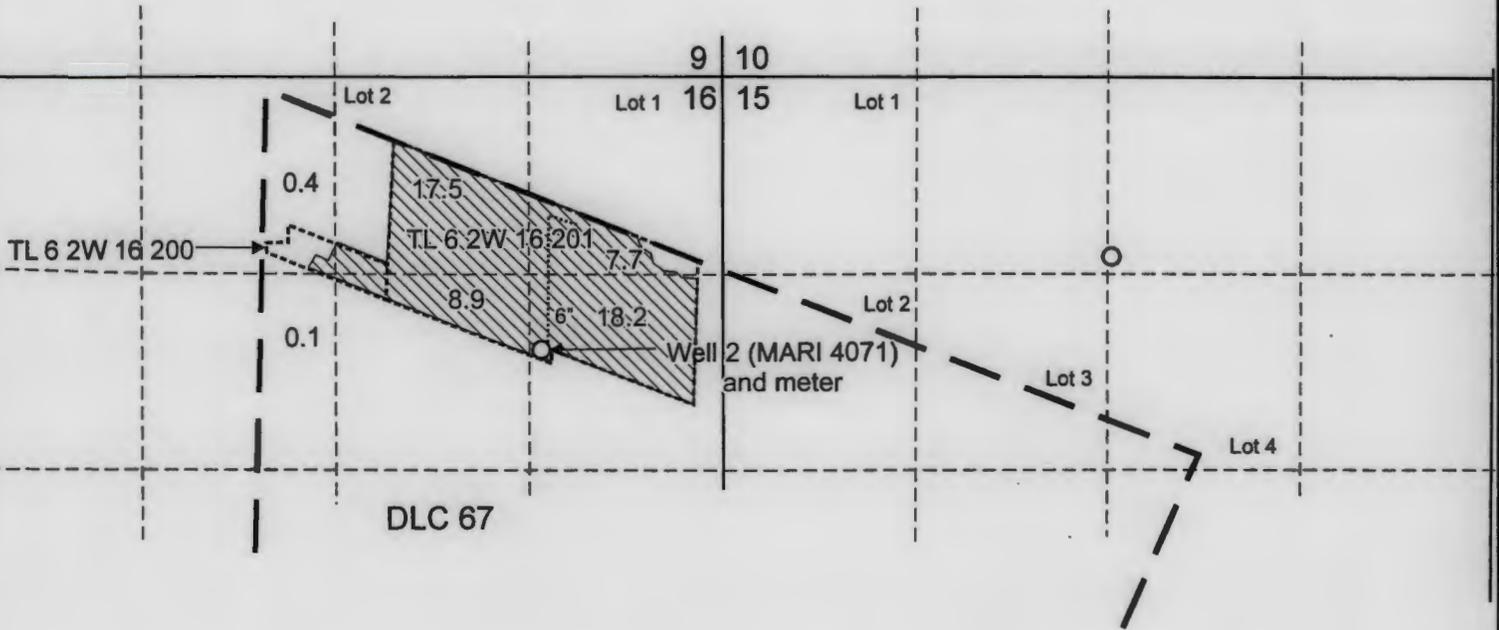

Well 2 (MARI 4071) and the meter are located 1,870 feet south and 1,255 feet west from the NE corner, Section 16.

 Area (52.8 Acres) of irrigator use under Application G-15101, Permit G-13836.

 Buried PVC Mainline


 Tax Lot Boundary

 Donation Land Claim (DLC) Boundary

RECEIVED

MAR 04 2016

WATER RESOURCES DEPT
SALEM, OREGON

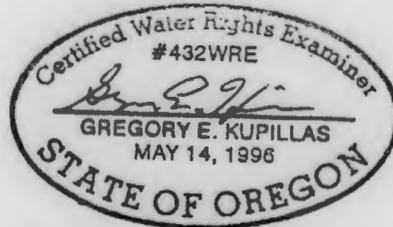

EXPIRATION DATE: 6/30/2017

Scale: 1" = 1,320'



This map was prepared for the purpose of identifying the location of a water right only and is not intended to provide legal dimensions or location of property ownership lines.

Claim of Beneficial Use Map
Application G-15101, Permit G-13836

Frank Henry
T.6S. R.2W. Section 16, W.M.

Pacific Hydro-Geology Inc.