


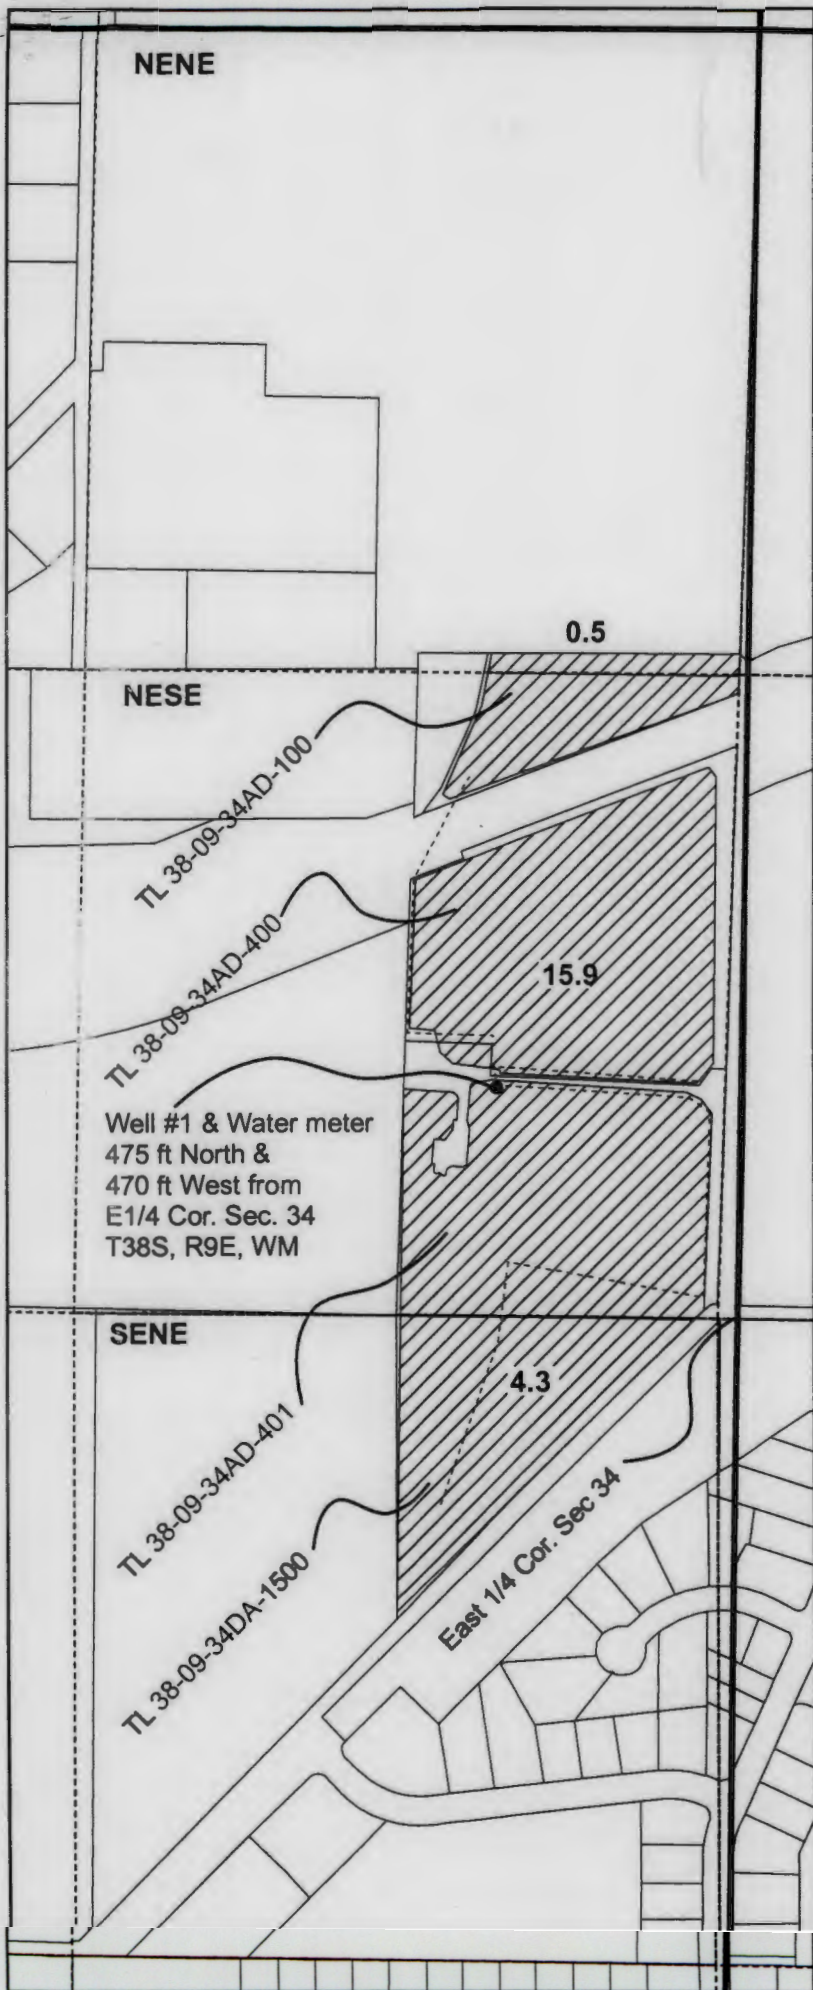



**Map of
Claim of Beneficial Use
Application G-16251
Permit G-15761
T 38 S, R 9 E, Sec. 34 W.M.**



Legend

-  Area irrigated
-  Main Line Pipe
-  Quarter-Quarter line
-  Section Line

 RECEIVED BY OWRC

AUG 08 2016

SALEM, OR



Scale 1" = 400'

Note: This map is for water right purposes only. It is not to be used for property line location.

