





1085



CLAIM OF BENEFICIAL USE MAP
APPLICATION R-87671 PERMIT R-14936
APPLICATION S-87771 PERMIT S-54746
FOR
MARK THORKELSON
1080 CANTRALL ROAD
JACKSONVILLE, OR 97530
LOCATED IN
TAX LOT 103, SECTION 32, T.38S., R.3W., W.M.
JACKSON COUNTY, OREGON

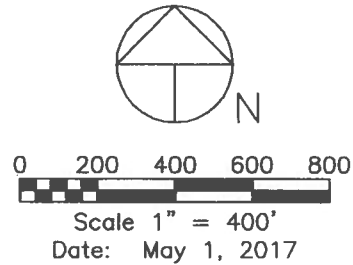

LEGEND

- Survey Monument
-  Denotes Place of Use Agriculture Use, Irrigation, Livestock
-  Denotes Staff Gage Location
-  Denotes Flow Meter Location
- Denotes Maximum Pool Level
- - - - Denotes Unnamed Creek
- △ Denotes Point of Diversion No. 1 Fish Screen at P.O.D.

This map was prepared for the purpose of identifying the location of a water right only and is not intended to provide legal dimensions or location of property ownership.

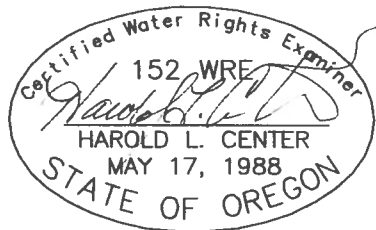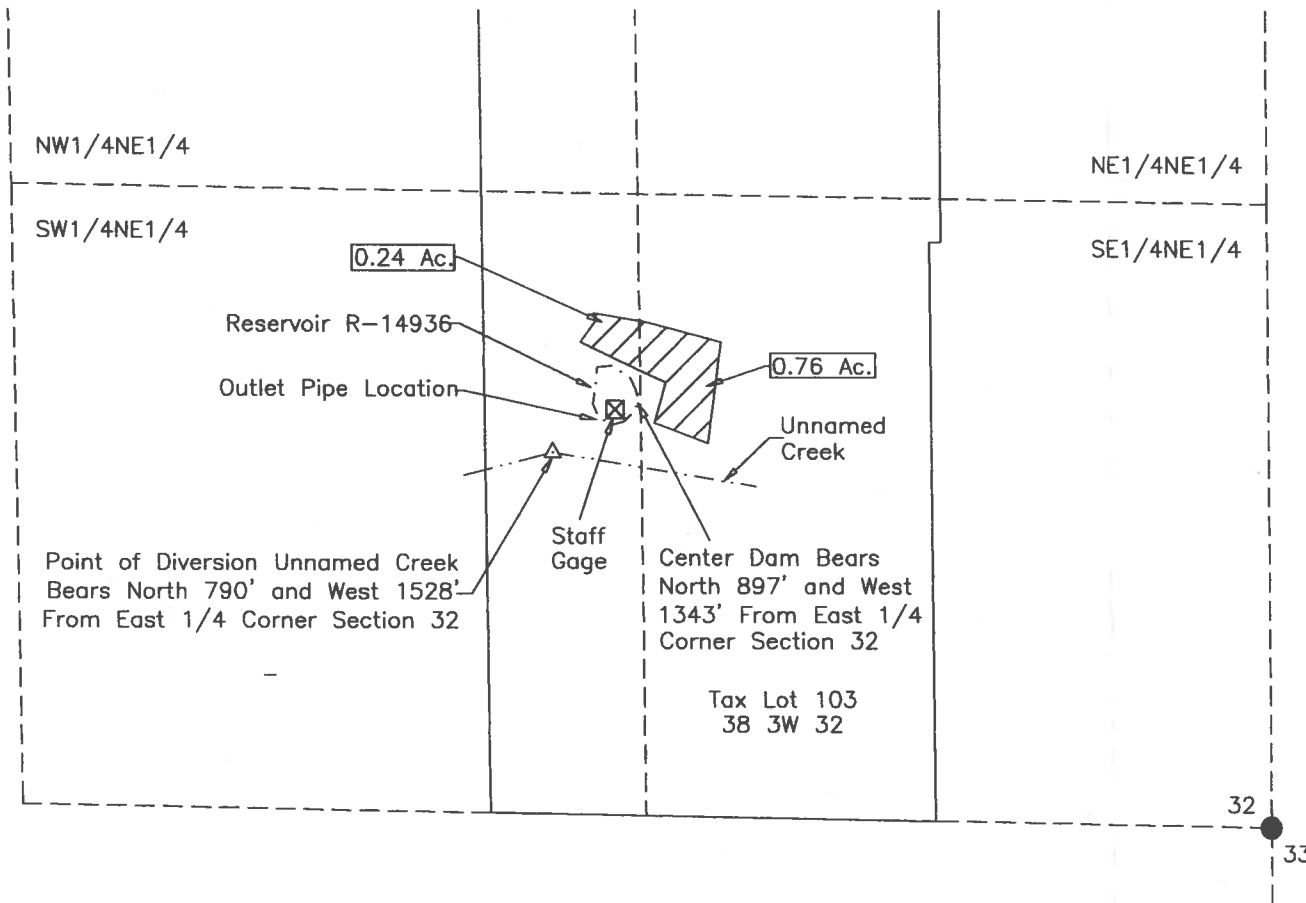

HAROLD L. CENTER
2604 David Lane
Medford, OR. 97504
Phone 541-535-6108
Oregon Certificate No. 152

Renews: 12/31/17

Project: 16-40 THORK.DWG

COBUI MAP # 1085

RECEIVED BY OWRD

JUN 12 2017

SALEM, OR