


T.7S., R.1W., W.M.

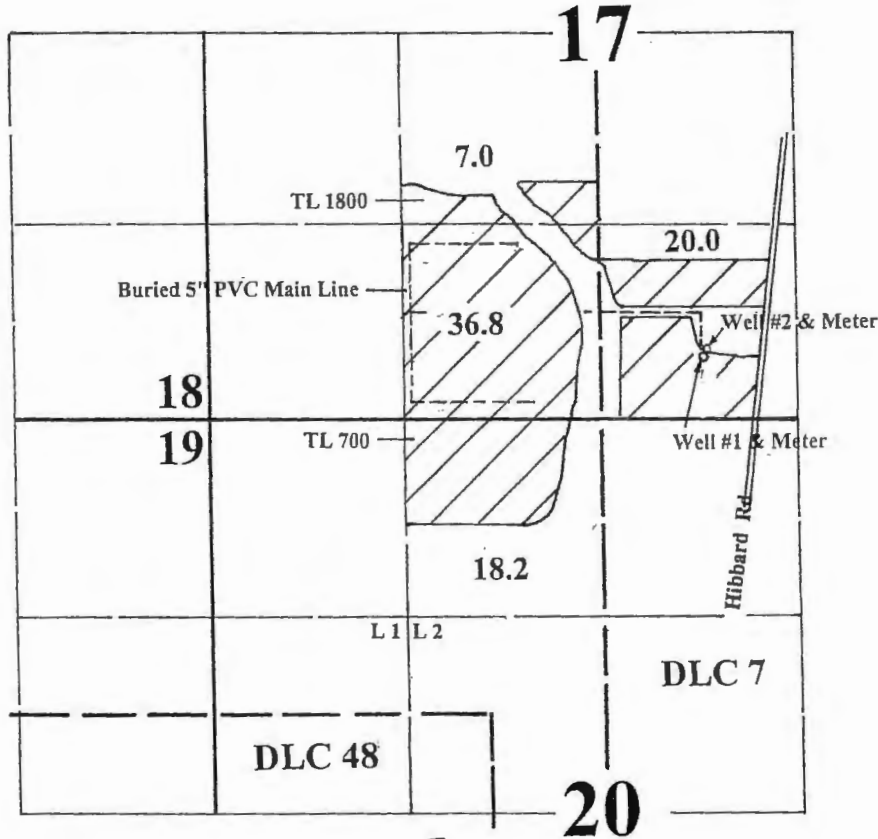

Well #1 is located 420' N and 694' W from the S1/4 corner of Section 17.
 Well #2 is located 432' N and 702' W from the S1/4 corner of Section 17.

E
AC/WRD
3/11/2020

Final Proof Survey


In the Name of

Kuenzi Bros. Farms

Transfer #: T-8329

Surveyed on September 29, 2015 by JM Schuette

This Map was Prepared for the Purpose of Identifying the Location of a Water Right Only and is Not Intended to Provide Legal Dimensions or Location of Property Ownership Lines

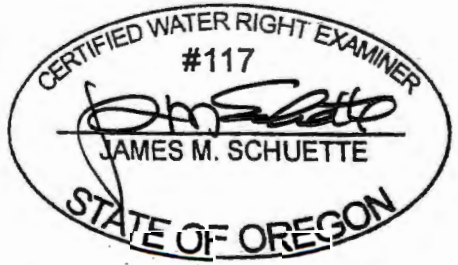

EXPIRES: 6-30-16