


Sections 19, 20, 26-36, T17S, R2W, W.M.
 Sections 14, 15, 21-28, 33-36, T17S, R3W, W.M.
 Sections 2-6, T18S, R2W, W.M.
 Sections 1-4, 10, 11, T18S, R3W, W.M.
 Lane County, Oregon

Application S-28213, Permit S-22200



CLAIM OF BENEFICIAL USE MAP
 Springfield Utility Board

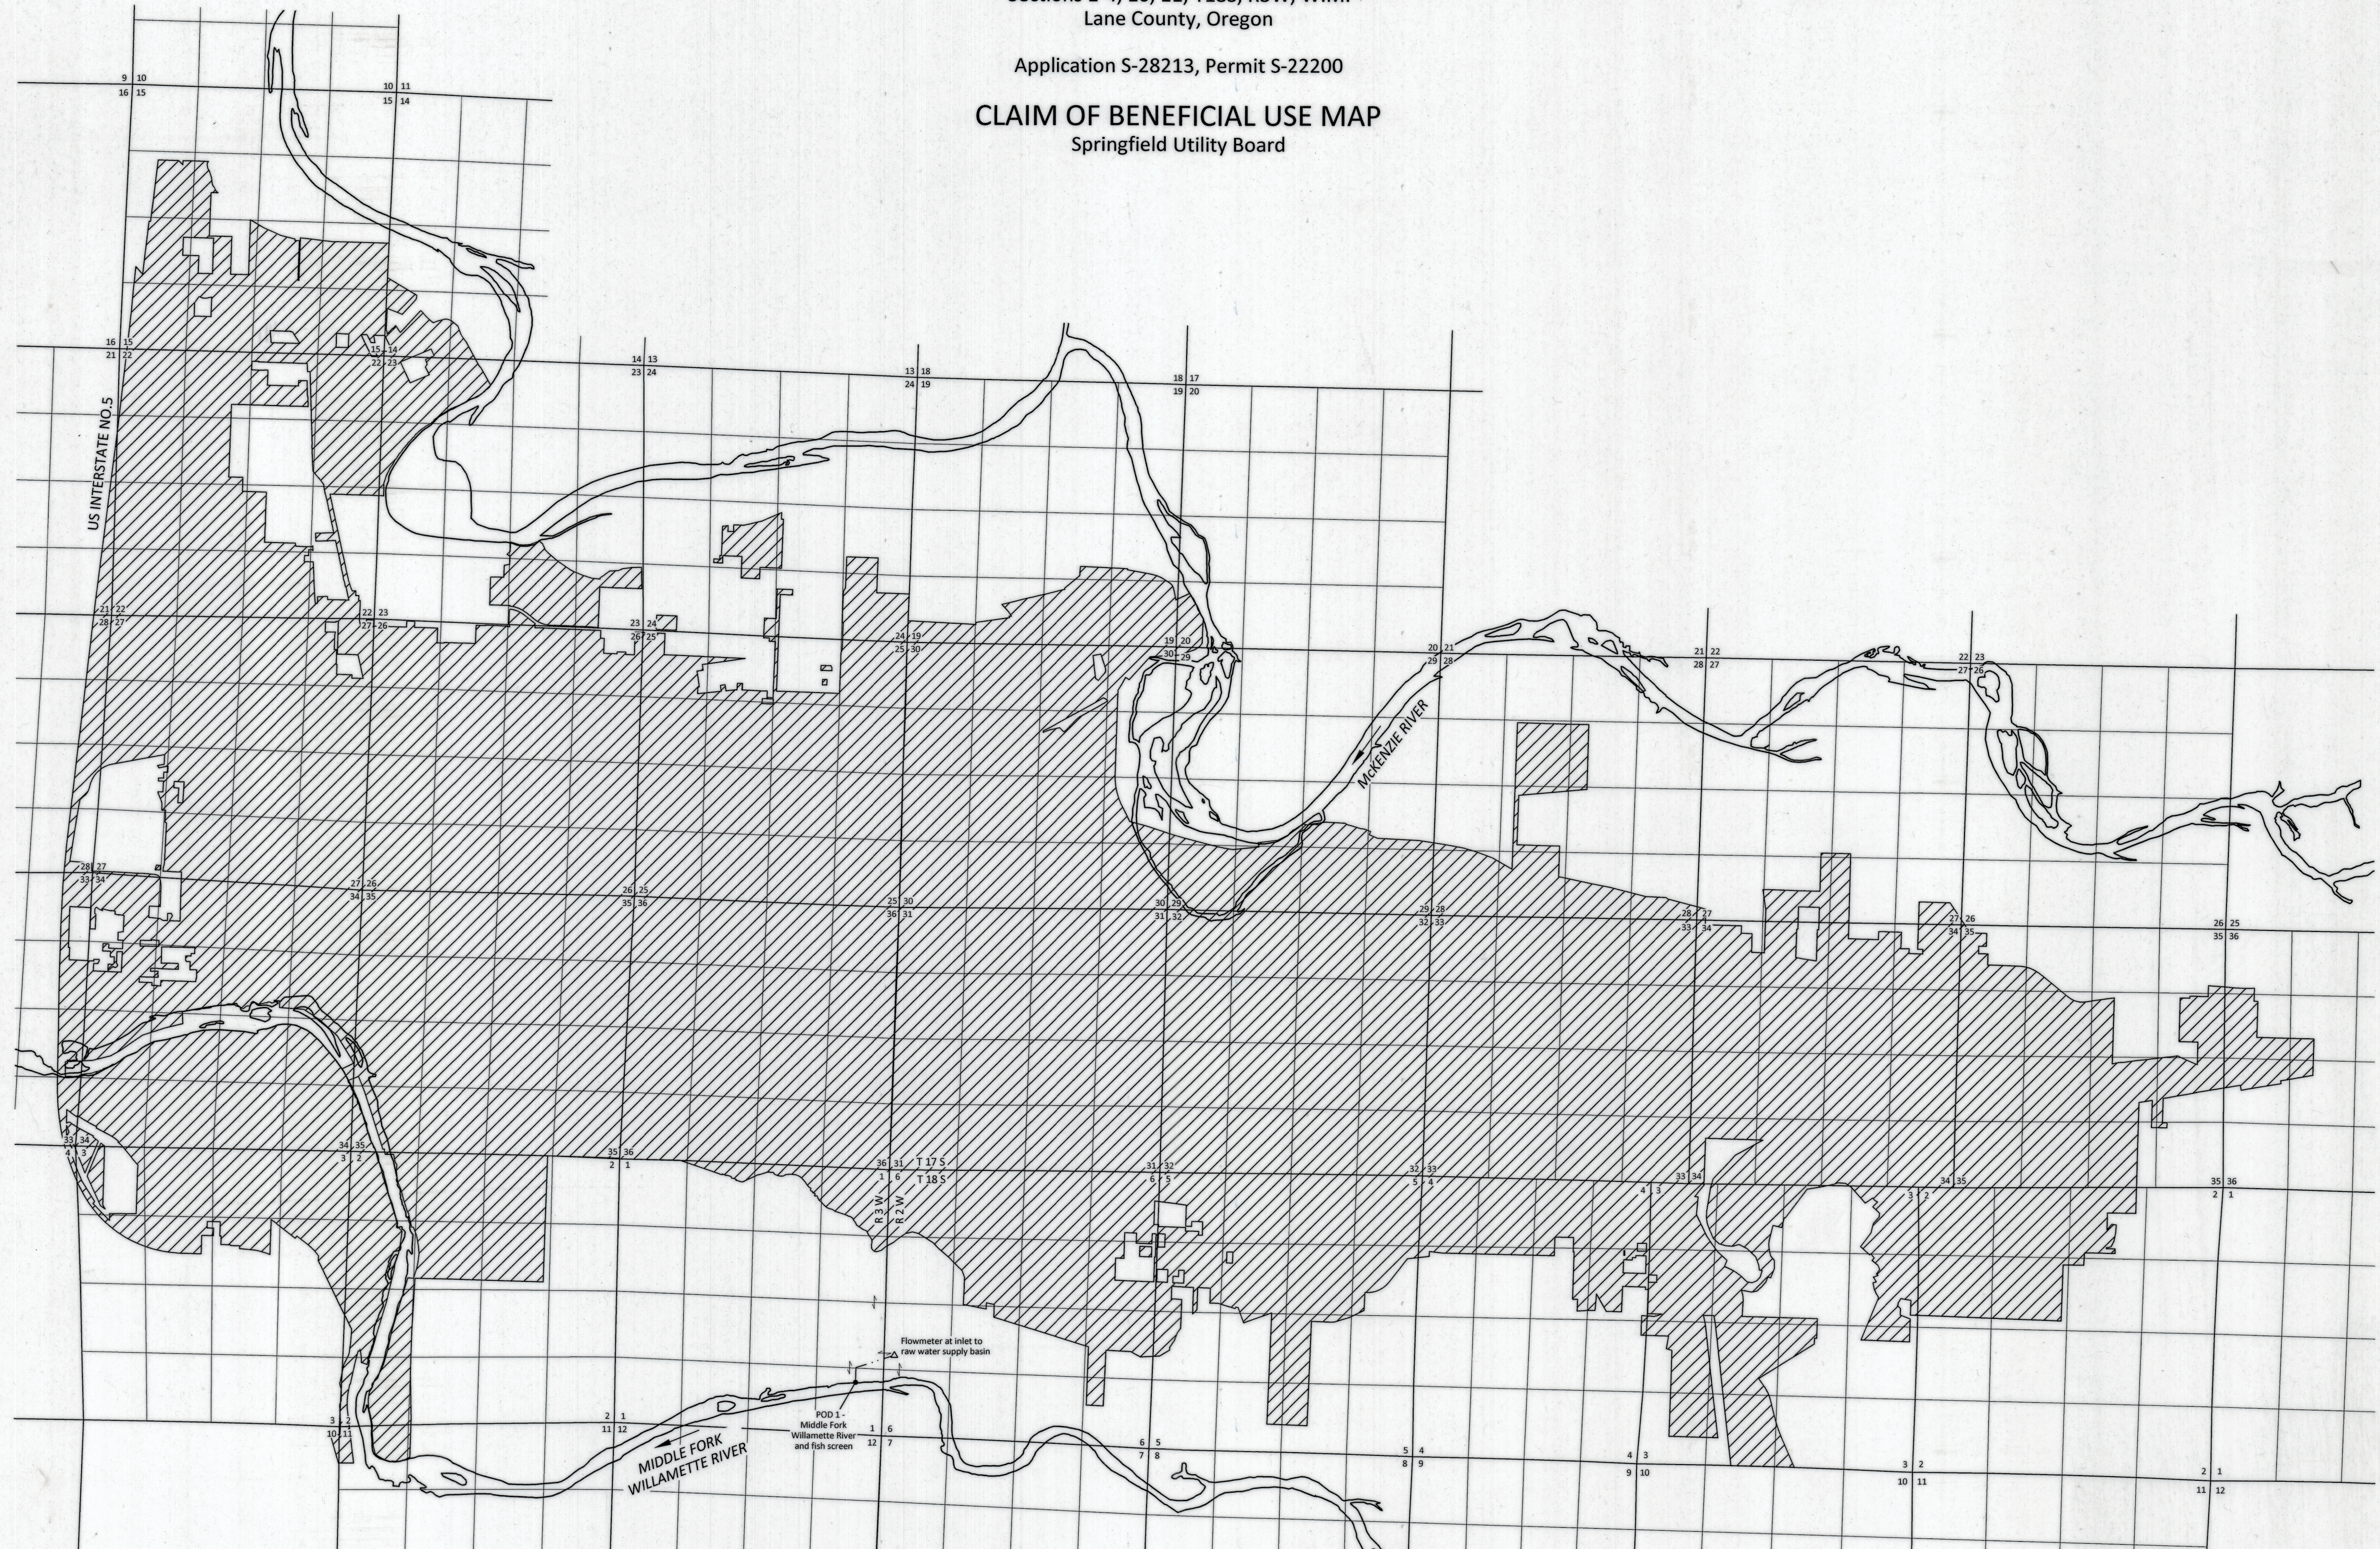

POD location: 1,080 feet North and 520 feet West from SE corner of Section 1, T18S, R3W, W.M.

EXPLANATION

- PLACE OF USE
PRIORITY DATE: MARCH 18, 1953
- POD
- FLOWMETER
- PIPE

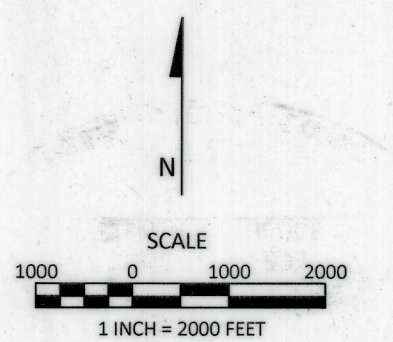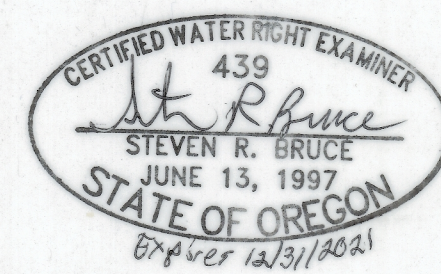

August 5, 2020

This map is not intended to provide legal dimensions or locations of property ownership lines

FIGURE 1