

**Claim of Beneficial Use
Application S-88253
Permit S-55036
for Supplemental Water of
Lost Creek Reservoir**


T36S R3W
Section 17, 18, 19 & 20

RECEIVED BY OWRD


NOV 20 2017

SALEM, OR

Del Rio Vineyards, LLC

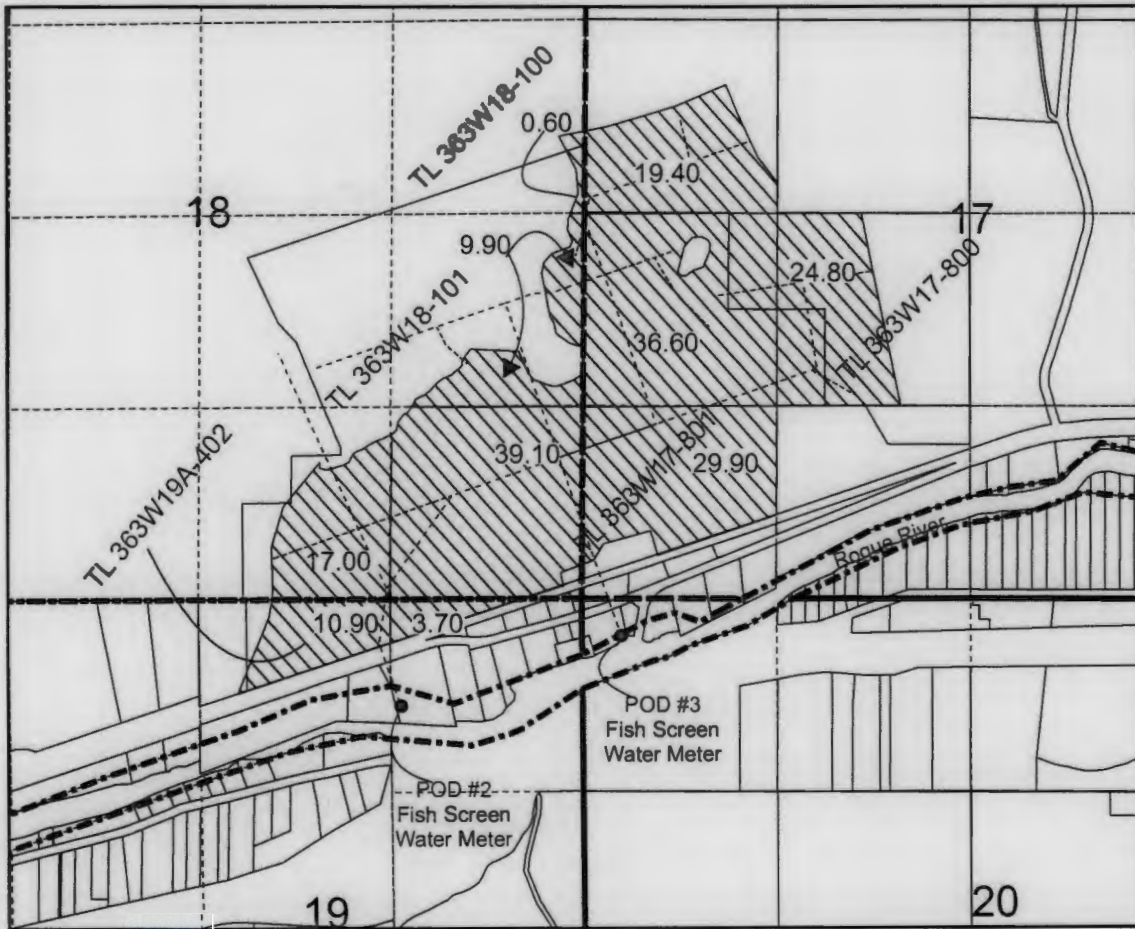

Legend

-  Area Irrigated
- POD, fish screen, and water meter
- Mainlines
- Lateral pipelines

Note: This map is not intended to provide legal dimensions or locations of property ownership lines.



1 inch = 1,320 feet

POD #2: 760' S & 1390' W
from SW Cor. Sec 17

POD#3: 270' S and 270' E
from SW Corner, Section 17

