



T.4S. R.1E Section 31, W.M.

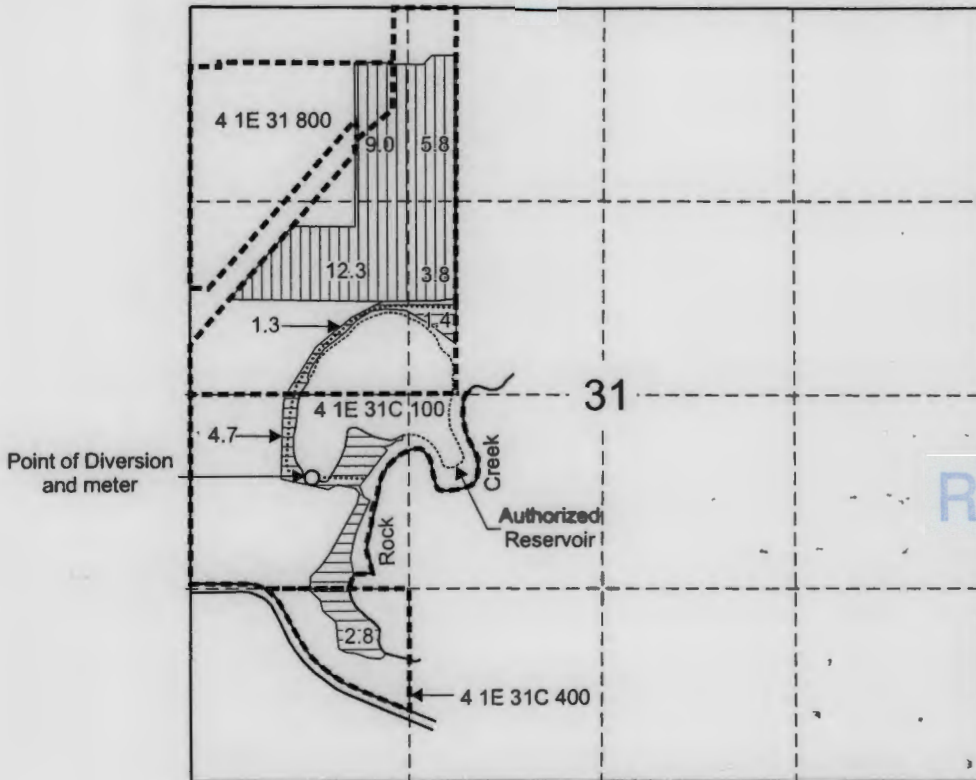

RECEIVED


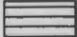

 
JUN 05 2017

OWRD

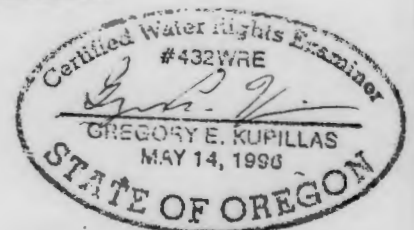

EXPIRATION DATE: 6/30/2019

Point of Diversion and meter are located 570 feet south and 830 feet east from the west 1/4 corner, Section 31.

-  Area (30.9 Acres) irrigated under Application S-80803, Permit S-52692, assigned to Warren Bean.
-  Area (10.2 Acres) irrigated under Application S-80803, Permit S-52692, assigned to Ray Neuschwander.
-  6-inch Mainline
-  Tax lot boundary

Scale: 1" = 1,320'



This map was prepared for the purpose of identifying the location of a water right only and is not intended to provide legal dimensions or location of property ownership lines.



Claim of Beneficial Use Map
Ray Neuschwander and Warren Bean

Application S-80803, Permit S-52692
T.4S. R.1E. Section 31, W.M.

Pacific Hydro-Geology Inc.

2017-hgp

Neuschwander_Bean.cdr