


**Claim of Beneficial Use Map
Place of Use
T-12082**
Morrow County, Oregon
Township 4 & 5 North,
Range 25 & 26 East (W.M.)

- LEGEND**
- Point of Appropriation (POA)
 - ▭ Port Service Area Boundary (POU)
 - Pipeline
 - ⊠ Government Lot (GL)
 - ⊕ Tax Lot
 - Major Road
 - ~ Watercourse
 - Waterbody

Certified Water Rights Examiner
 #78208WRE
Bruce Brody-Heine
 Bruce Brody-Heine
 June 29, 2007
 STATE OF OREGON

EXPIRES: 12-31-21

DISCLAIMER
 This map was prepared for the purpose of identifying the location of a water right only and it is not intended to provide legal dimensions or location of property ownership lines.

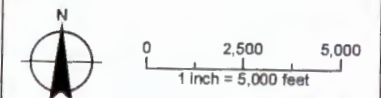


Date: July 10, 2020
 Data Source: USGS, BLM, ESRI, Morrow Co.

Claim of Beneficial Use Map Points of Appropriation

T-12082

Morrow County, Oregon

Township 4 North, Range 25 East (W.M.)

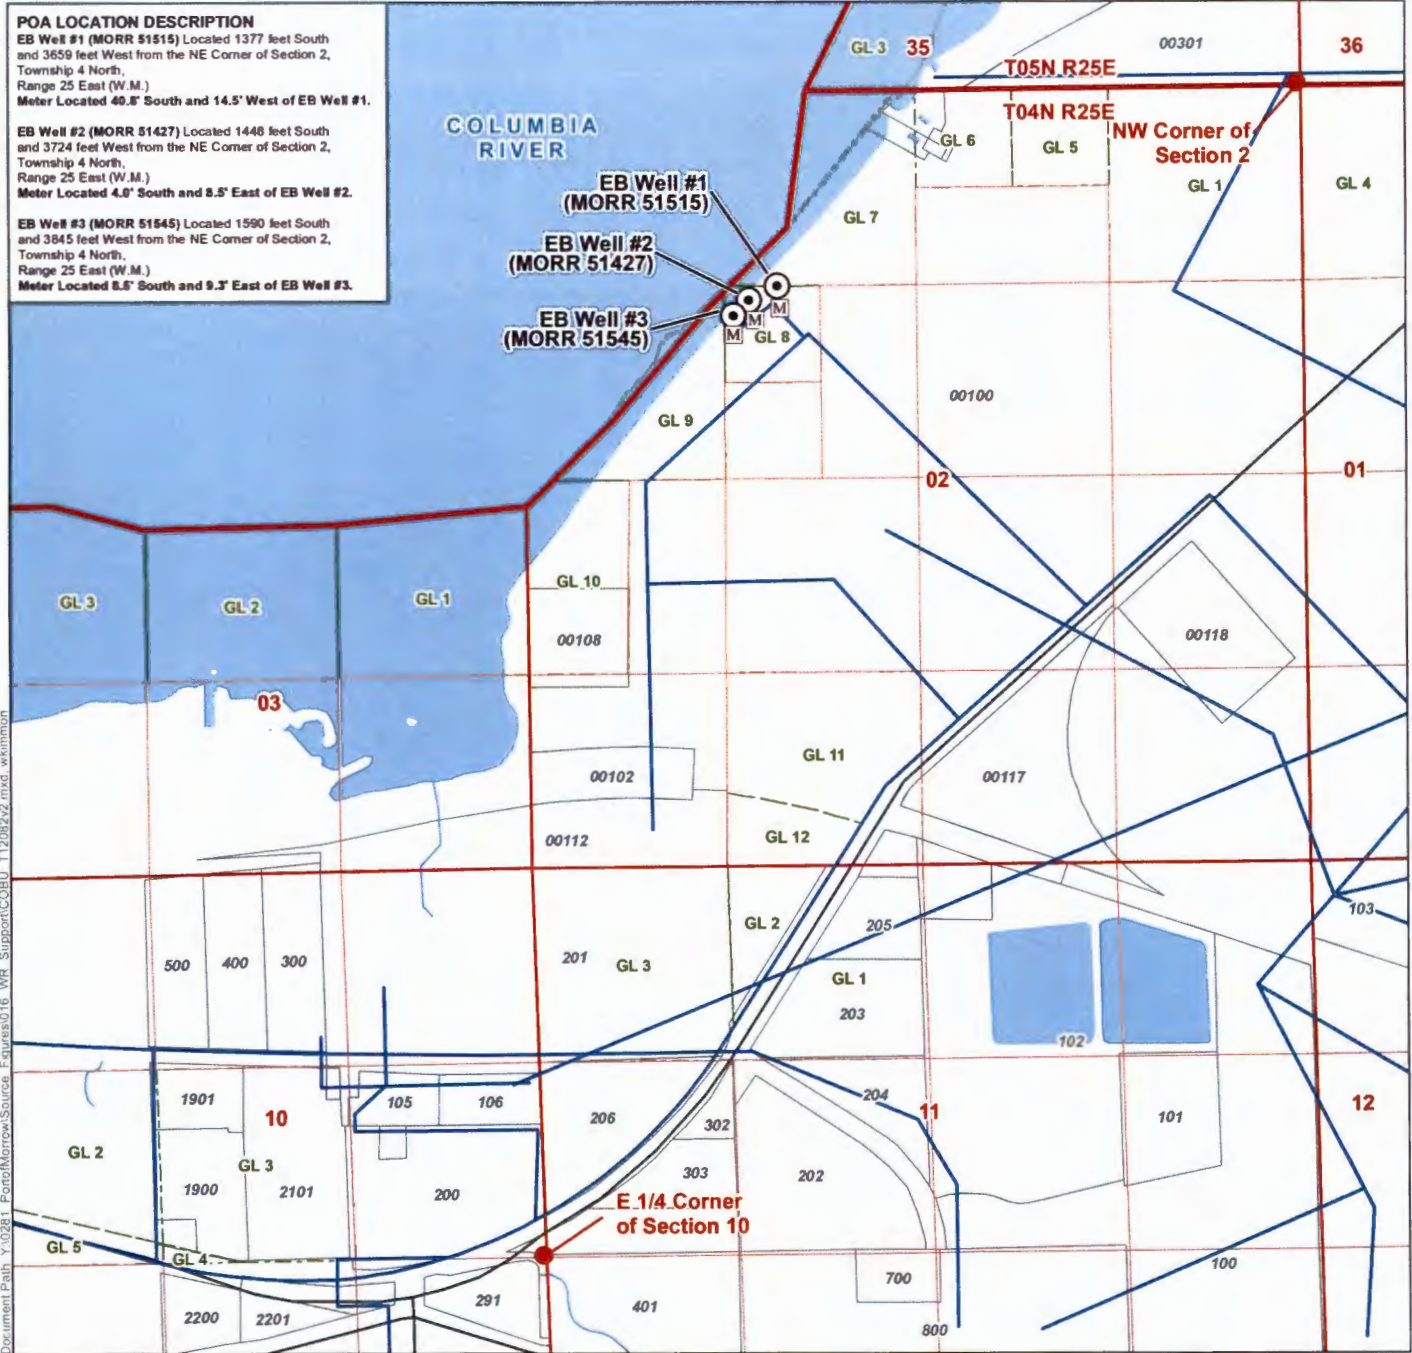


LEGEND

- ⊙ Point of Appropriation (POA)
- Ⓜ Totalizing Flowmeter
- Pipelines
- Government Lot (GL)
- ⊕ Tax Lot
- Major Road
- ~ Watercourse
- Waterbody

DISCLAIMER

This map was prepared for the purpose of identifying the location of a water right only and it is not intended to provide legal dimensions or location of property ownership lines.

Certified Water Rights Examiner Stamp

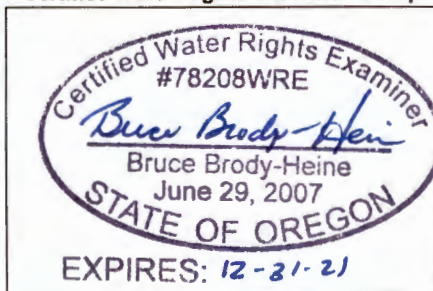

RECEIVED
OCT 13 2020
OWRD

DISCLAIMER

This map was prepared for the purpose of identifying the location of a water right only and it is not intended to provide legal dimensions or location of property ownership lines.

MAP NOTES

Date: October 7, 2020
Data Sources: USGS, BLM, ESRI, Morrow Co.

