




Amended Map received by email
10-26-2020

Vale Oregon Irrigation District
T 16 R 43 Sec 26
Goettsche Joint Family Trust

Received by OWRD

SEP 26 2020

Salem, OR

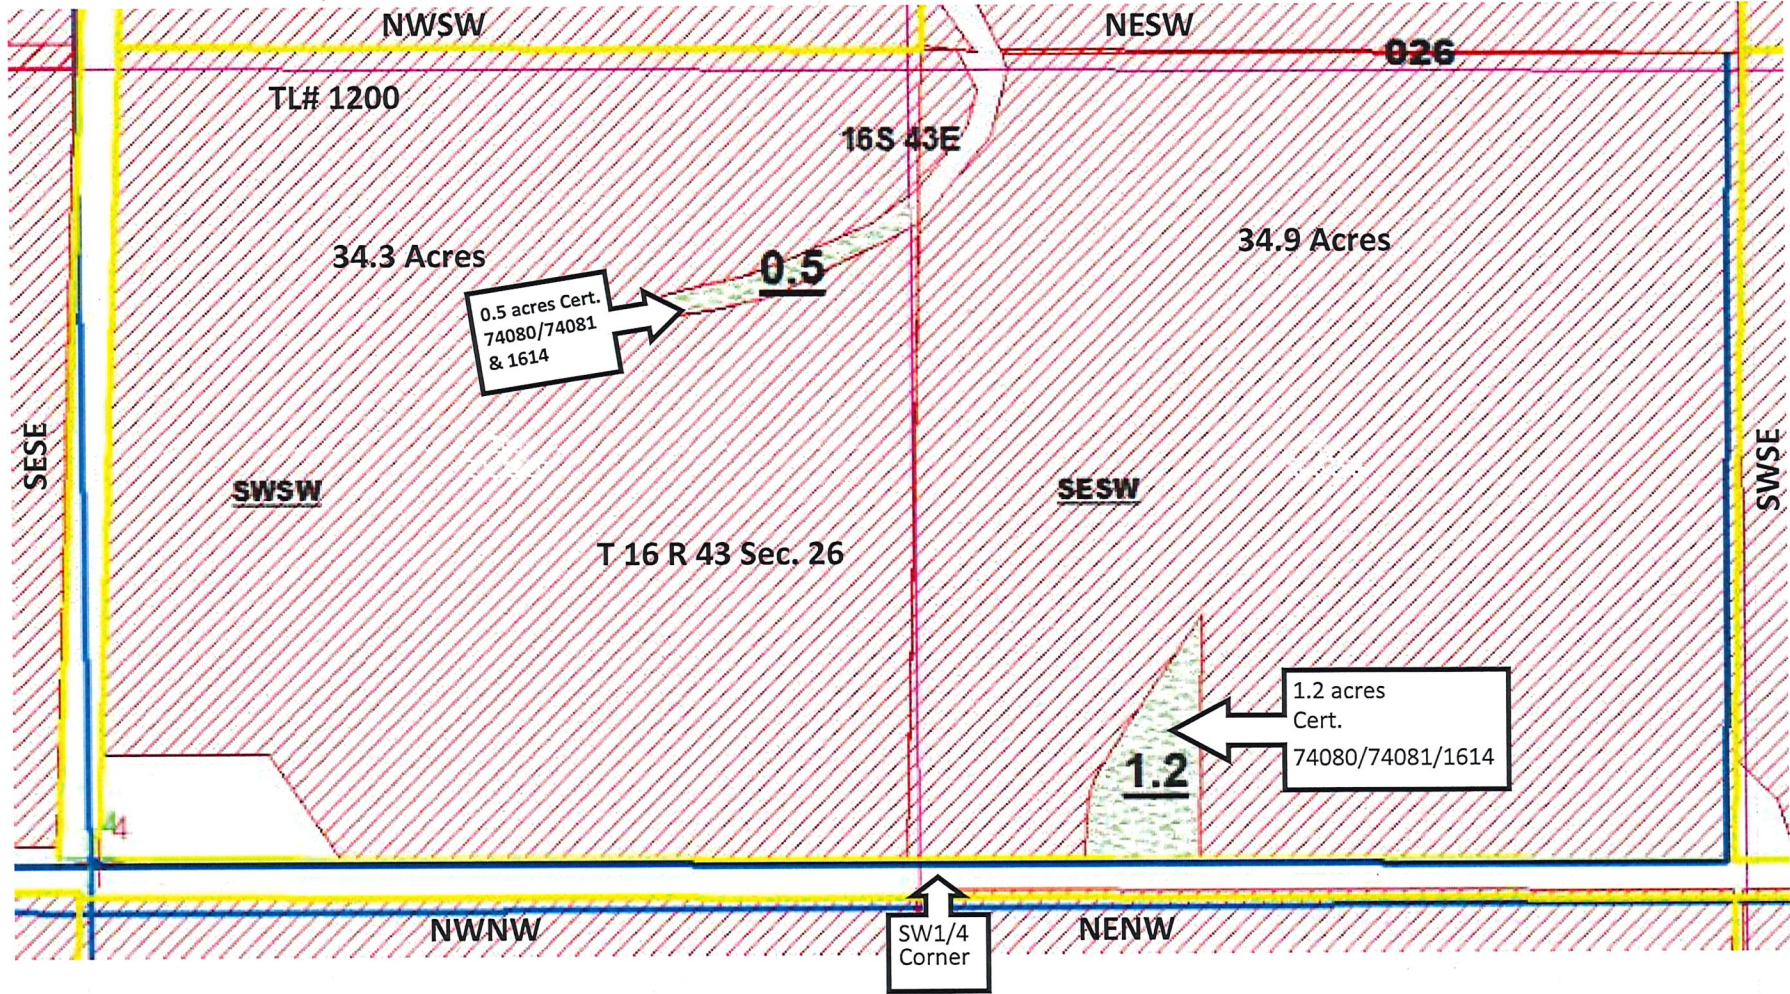

0.5 acres Cert.
74080/74081
& 1614

1.2 acres
Cert.
74080/74081/1614

Legend	
	GJFT_Remaining_ 82.6 Acres
	GJFT_To_1.7Acres 74080 (IR) 74081 (IS)
	GJFT_To_1.7 Acres 1614 (IS)

Certificate: 74080 IR
74081 (IS)
1614 (IS)

Claim of Beneficial Use Transfer	
Tax Lot #1200	1.7 acres on Cert. 1614
	1.7 acres on Cert. 74080
	74081