


FOR
CARRIE BROWN

RECEIVED BY OWRD

OCT 26 2016

SALEM, OR

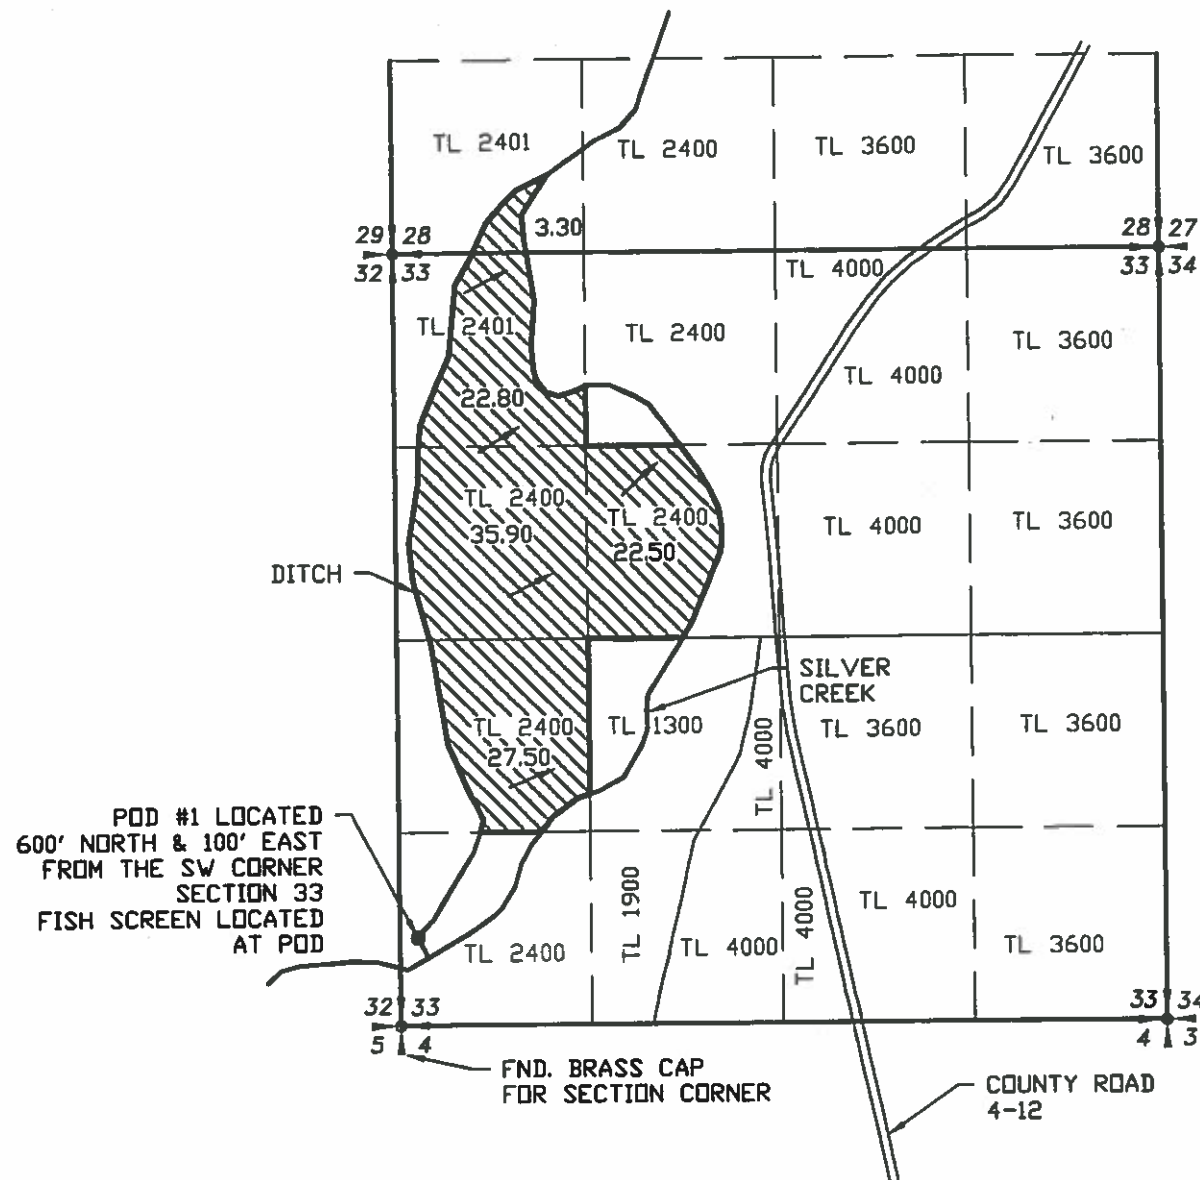

 SECTION LINE
 1/4 SECTION LINE
 1/16 SECTION LINE
 TAXLOT LINE
 FLOOD FLOW DIRECTION



PLACE OF USE

APPLICATION NO. S-86178

PERMIT NO. S-54193



RENEWAL 12/31/17

NOTE:
PREPARATION OF THIS MAP IS FOR IDENTIFYING PROPOSED
WATER RIGHTS ONLY. IT HAS NO INTENT TO PROVIDE
LOCATIONS OR DIMENSIONS OF PROPERTY BOUNDARIES.

COBU MAP # 1047

REVISION	BY

**ANDERSON ENGINEERING
AND SURVEYING, INC.**

P.O. BOX 28
LAKEVIEW, OREGON 97630
(541) 847-4407/FAX: 847-2321
WWW.ANDERSONENGINEERING.COM

**FOR:
LANCE BROWN
P.O. BOX 100
SILVER LAKE, OR 97638
541-410-8490**

**CLAIM OF BENEFICIAL USE
APPLICATION NO.S-86178
PERMIT NO. S-54193**

DATE:	8/29/2016
SCALE:	1"=1320'
DWG. BY:	R.C.
JOB:	2016-062
FILE:	2016-062
SHEET:	1 OF 1