


CLAIM OF BENEFICIAL USE MAP
WATER RIGHTS TRANSFER - T-11626
MOUNTAIN VIEW RANCH
 LOCATED IN SECTION 31, TOWNSHIP 14 SOUTH,
 RANGE 15 EAST, W.M. CROOK COUNTY

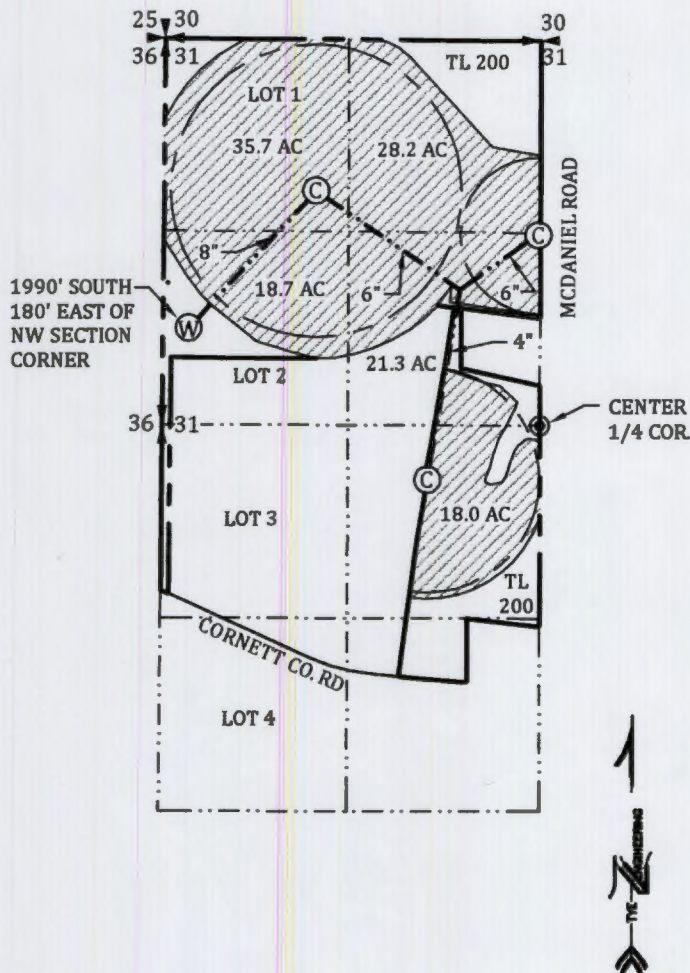

-  WATER RIGHTS
-  MAINLINE WATER
-  WELL
-  CENTER OF PIVOT

WATER RIGHTS (PARCEL 1)

NE1/4 NW1/4	28.2 AC
GOV. LOT 1	35.7 AC
GOV. LOT 2	18.7 AC
SE1/4 NW1/4	21.3 AC
NE1/4 SW1/4	18.0 AC
TOTAL	121.9 AC


I, CHANCE T. STEFFEY, CERTIFIED WATER RIGHT EXAMINER IN THE STATE OF OREGON, HEREBY CERTIFY THE ABOVE CLAIM OF BENEFICIAL USE MAP WAS PREPARED UNDER MY DIRECT SUPERVISION.

THE PREPARATION OF THIS MAP IS FOR THE PURPOSE OF IDENTIFYING THE LOCATION OF THE WATER RIGHT ONLY AND HAS NO INTENT TO PROVIDE DIMENSIONS OR LOCATIONS OF PROPERTY OWNERSHIP LINES.

RECEIVED BY OWRD SCALE 1" = 1320'

NOV 17 2016

SALEM, OR

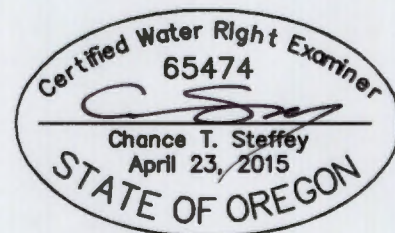

RENEWS: June 30, 2018

TYE ENGINEERING, INC.

725 NW HILL, BEND, OREGON 97701 (541) 389-6959

DATE: NOV. 2, 2016

SCALE: 1" = 1320'

DRAWN BY: P.A.T.

JOB: 1936_Erickson COBU.dwg