


# T.4S. R.1E. Section 20, W.M.

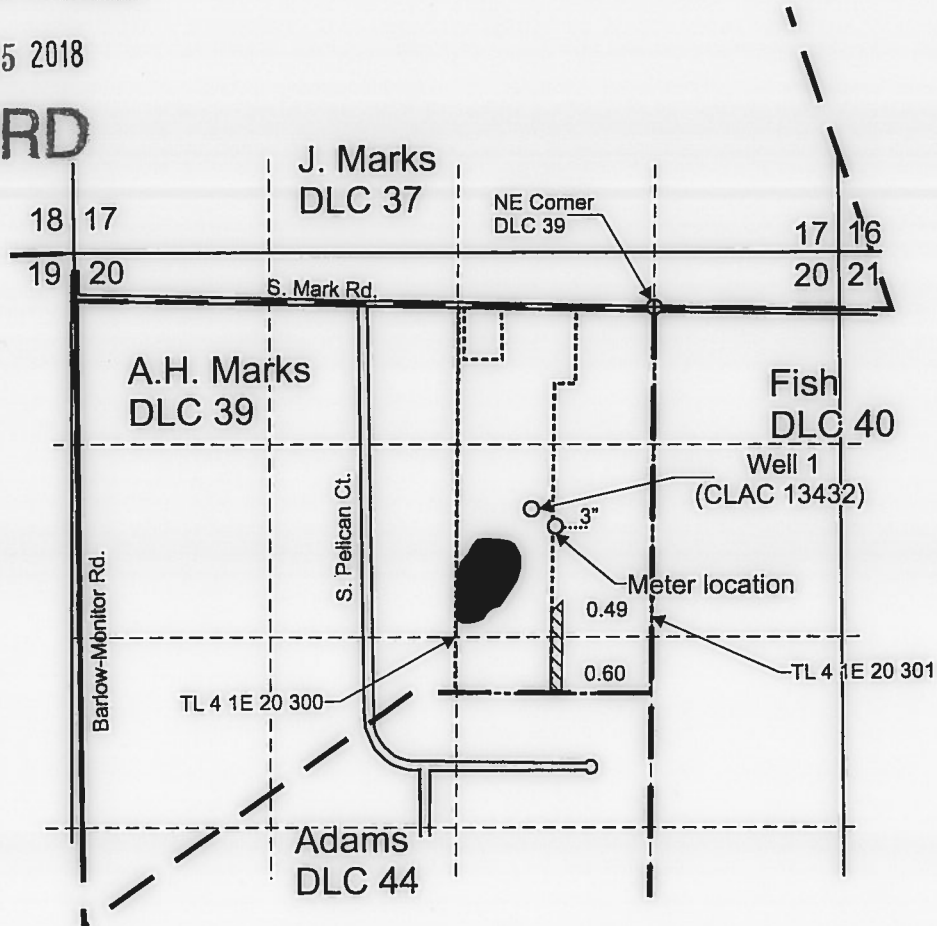



RECEIVED

APR 25 2018

OWRD



Well 1 (CLAC 13432) is located 1,386 feet south and 858 feet west from the NE corner, DLC 39.

-  Area (1.09 Acres) irrigated under T-10194.
-  Tax Lot boundary
-  Donation Land Claim boundary
-  Water main line



RECEIVED JUN 30 2018

Scale: 1" = 1,320'



This map was prepared for the purpose of identifying the location of a water right only and is not intended to provide legal dimensions or location of property ownership lines.



## Claim of Beneficial Use Map T-10194

George and Zina Reutov  
T.4S. R.1E. Sec. 20, W.M.

Pacific Hydro-Geology Inc.

04/2018