


CLAIM OF BENEFICIAL USE

TRANSFER T-11289

(CHANGE IN POINT OF DIVERSION)

TOWNSHIP 38 SOUTH RANGE 8 WEST, W.M.

JOSEPHINE COUNTY OREGON

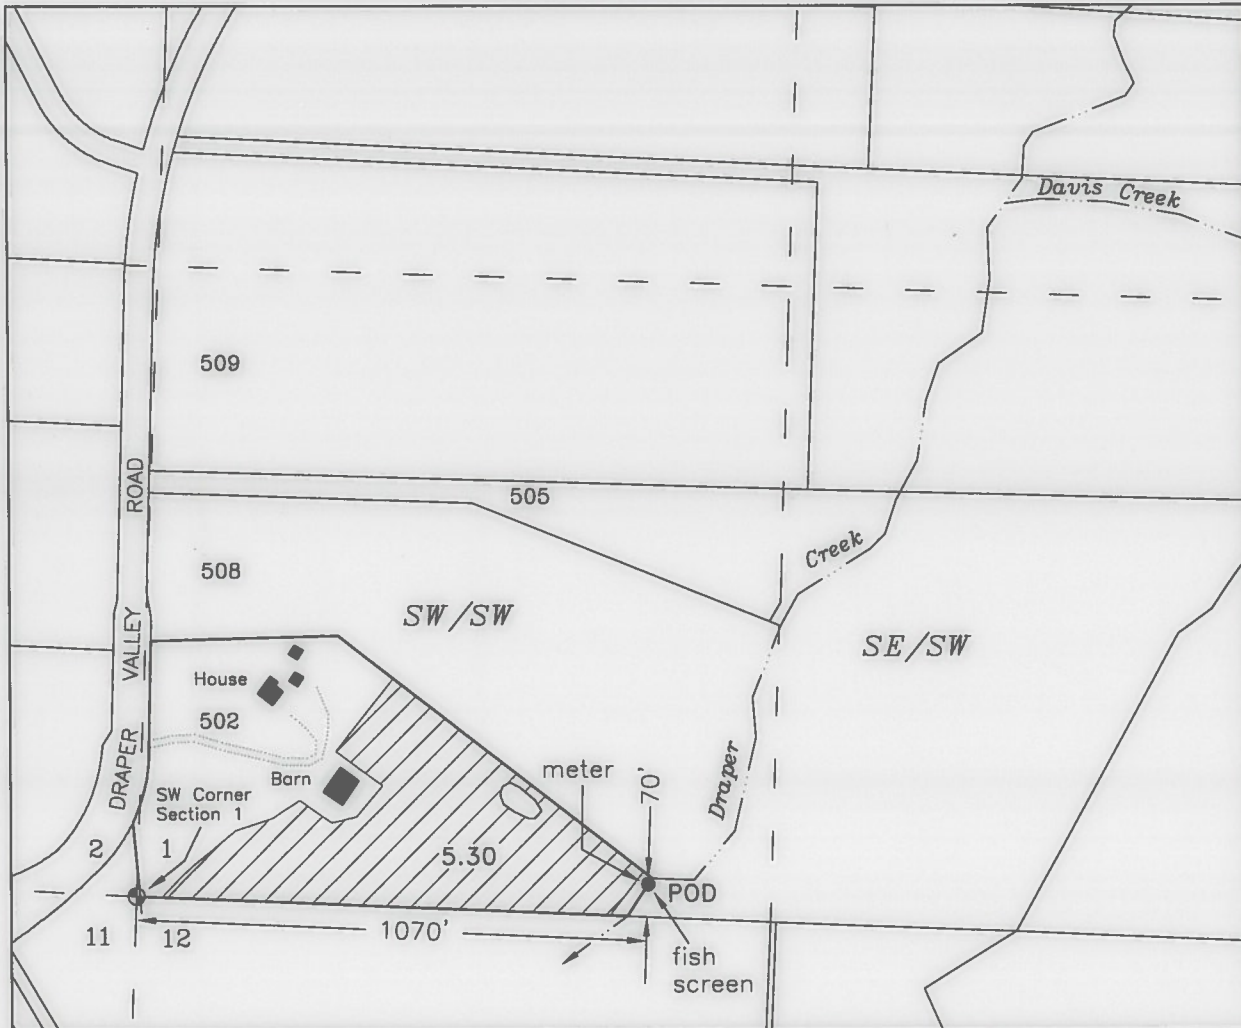

LEGEND



Irrigation
5.3 Acres

Prepared For:
Danny M. Cook

Agent:
Jessica Karr
P.O. Box 725
Selma, OR 97538


RECEIVED

JUL 20 2018

OWRD

This map is not intended to provide legal
dimensions or locations of property ownership lines

SCALE: 1" = 400'
0' 200' 400' 800'

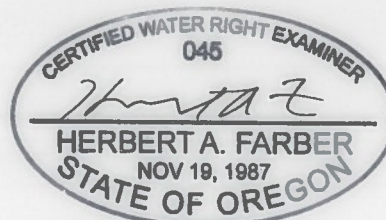

EXPIRES: 12/31/2019

Base Map - Josephine County GIS tax lots,
overlaid with maps for permit S-4488,
T-3920 & current Oregon Map aerial
for assumed best fit

5/25/1018 n.e.d.