
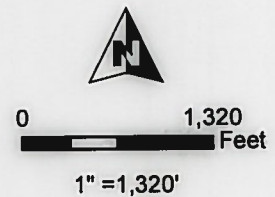


T14S R12E, SECTION 36 AND  
T15S R12E, SECTIONS 1 & 2, WM

DESCHUTES COUNTY, OREGON

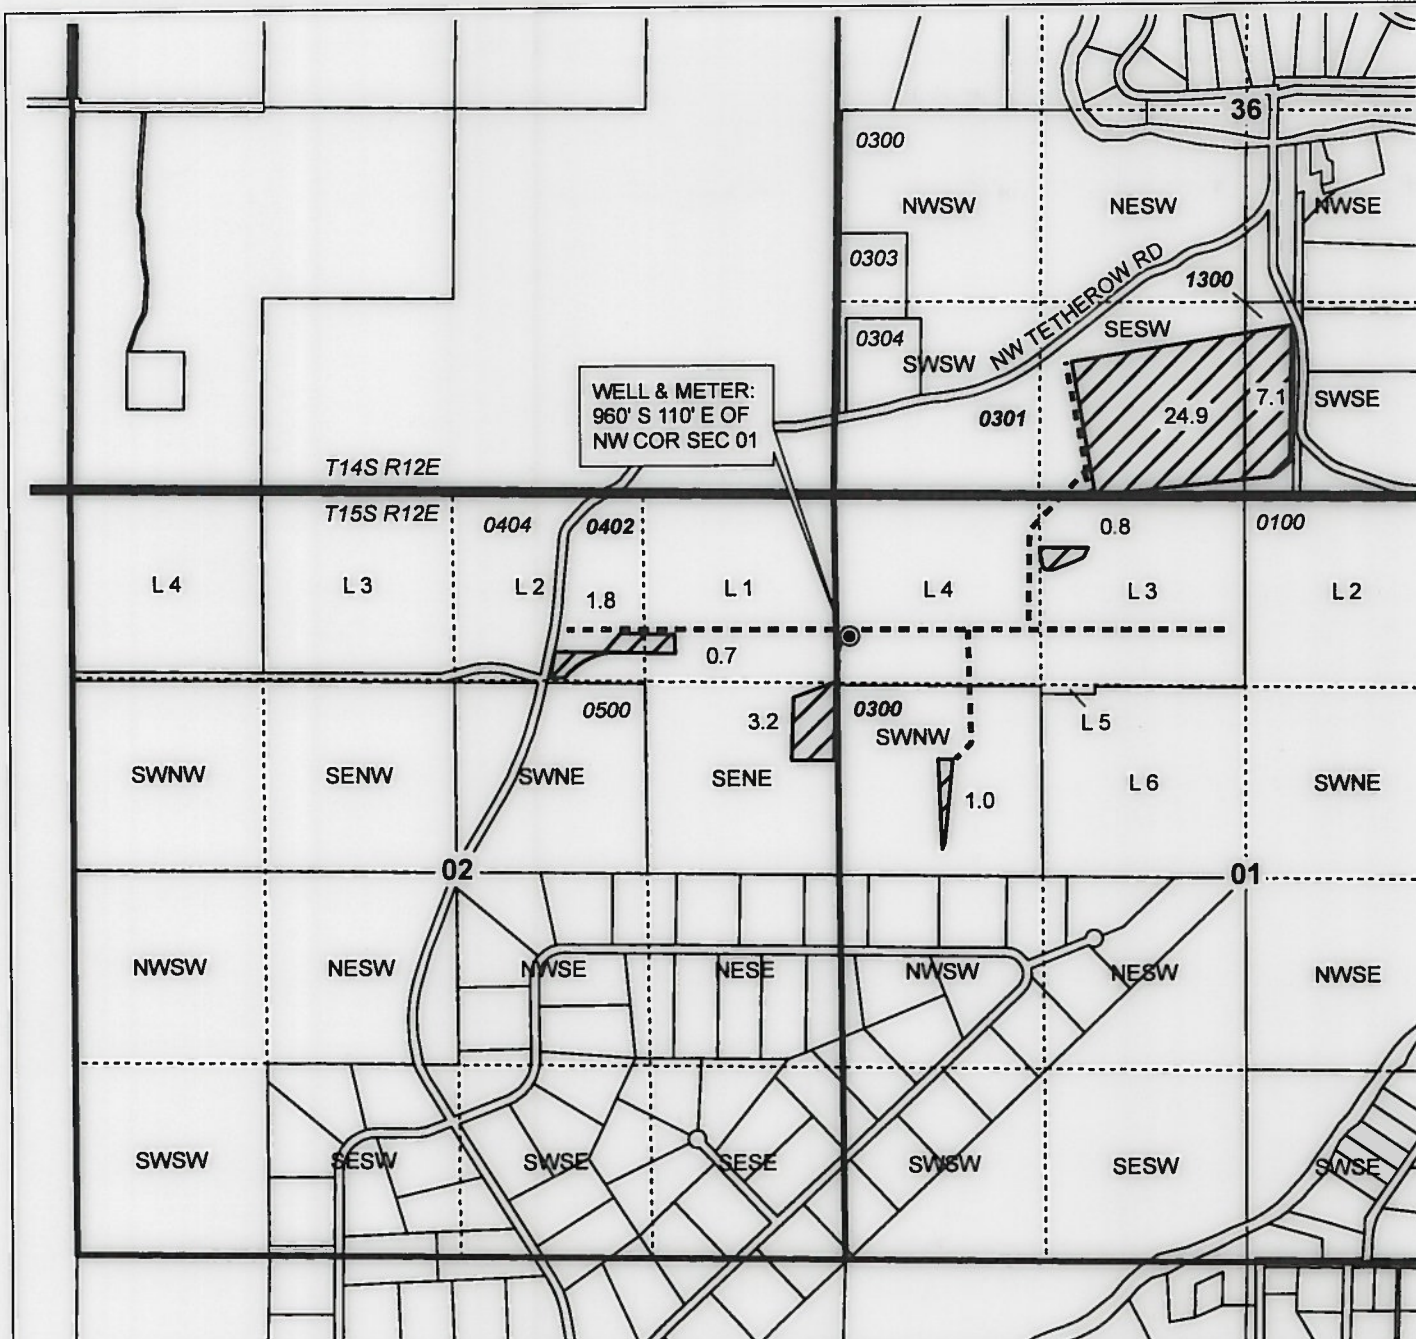

- POUIR
- Township
- Section
- Quarter Quarter
- Tax lot
- Well
- Pipelines

RECEIVED

JAN 26 2018

OWRD



RENEWAL DATE 12/31/2018



**CLAIM OF BENEFICIAL USE MAP**  
Stabb Living Trust

TRANSFER T-12279

NOTE: THIS MAP IS NOT INTENDED TO  
PROVIDE LEGAL DIMENSIONS OR LOCATIONS  
OF PROPERTY OWNERSHIP LINES.

Job # 17010

DECEMBER 13, 2017

**WATER RIGHT SERVICES, LLC**  
PO BOX 1830, BEND, OR 97709  
CCB# 197121 [www.oregonwater.us](http://www.oregonwater.us)  
541-389-2837 JOHNSHORT@USA.COM