


T.13 & 14 S., R.34E., W.M.

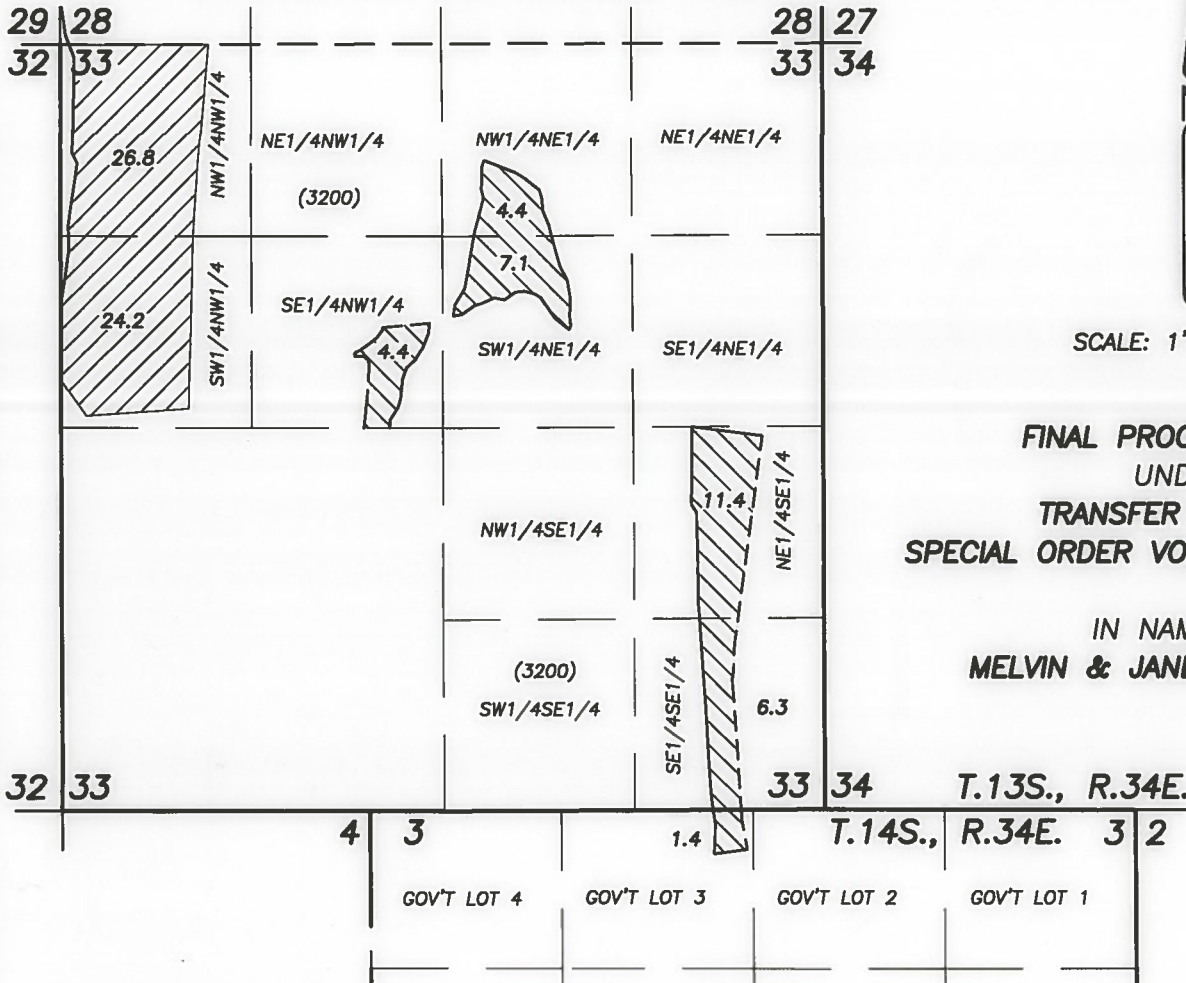

SCALE: 1" = 1320'

FINAL PROOF SURVEY  
UNDER  
TRANSFER T-12129  
SPECIAL ORDER VOL. 101, PAGE 900


IN NAME OF  
MELVIN & JANET ZWEYGARDT

RECEIVED


MAR 05 2018

OWRD

T14S, R34E

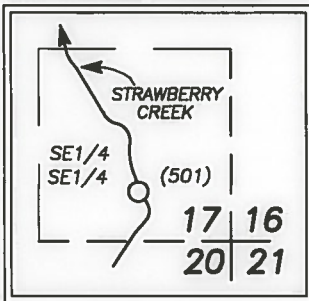

T14S, R34E,  
SECTION 10

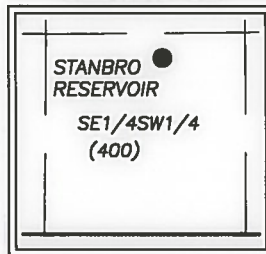

PREPARED BY:  
ROBERT D. BAGETT, PLS, CWRE  
217 N. CANYON BLVD.  
JOHN DAY, OREGON  
(541) 575-1251  
FEBRUARY 7, 2018

○ POD #1 - STRAWBERRY CREEK  
WEIR WITH STAFF PLATE BEARS NORTH, 8 FT. FROM POD

▨ PRIMARY

● POD #2 - STANBRO RESERVOIR  
WEIR WITH STAFF PLATE BEARS SOUTH, 333 FT. FROM Q DAM

▨ SUPPLEMENTAL

( ) TAX LOT NO.



RENEWS: 12/31/2019

DISCLAIMER: THIS MAP IS NOT INTENDED TO PROVIDE LEGAL DIMENSIONS OR LOCATIONS OF PROPERTY BOUNDARY LINES.