


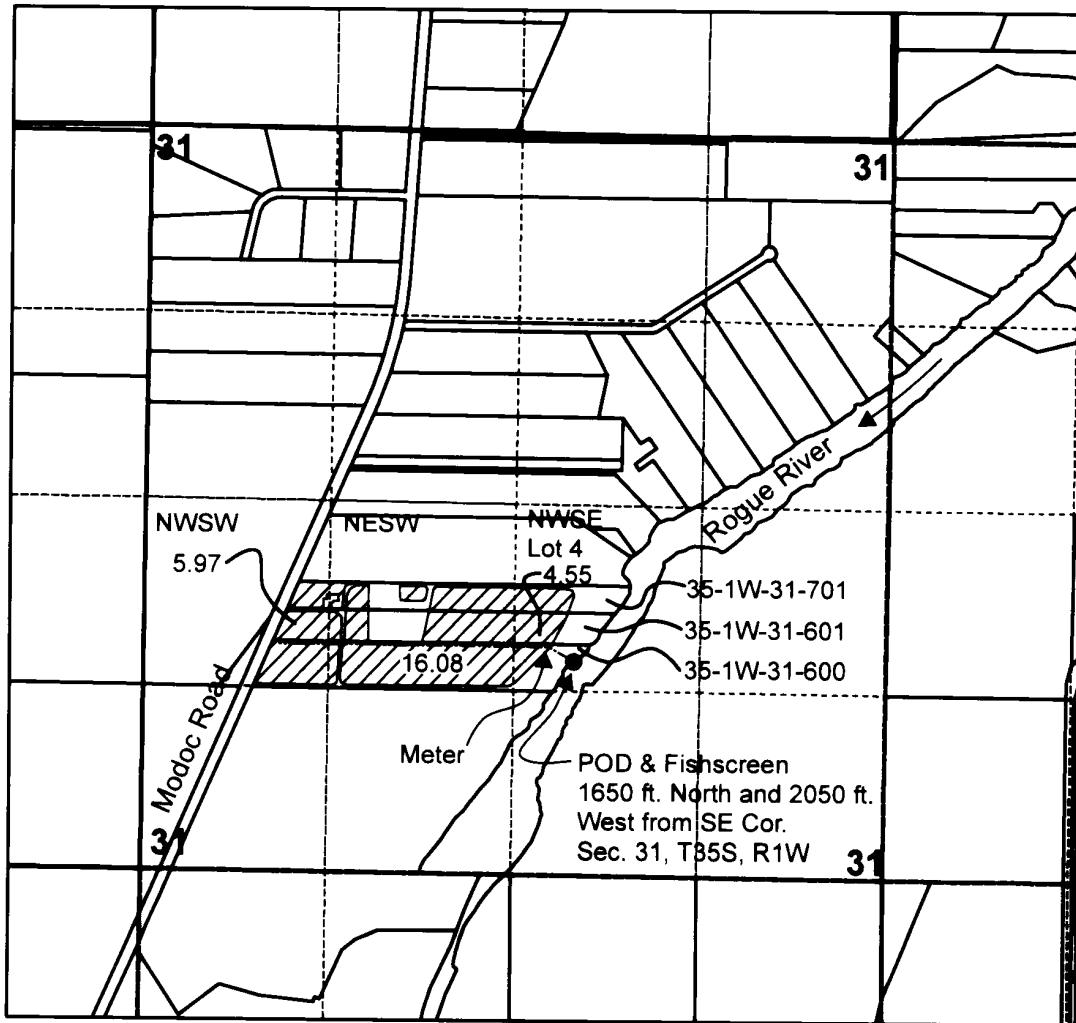


Map of Claim of Beneficial Use T 35 S, R 1 W, Sec. 31
Application S-87214
Permit S-54676
RRIP, Limited



Legend

- Pipe line
-  Supplemental Irrigation
-  Section line
-  Quarter-Quarter line



1 inch = 1,320 feet
RECEIVED BY OWRD

DEC 05 2016

SALEM, OR

This map is not intended to provide legal dimensions or locations of property ownership lines.

