


TOWNSHIP 13 SOUTH, RANGE 9 EAST, W.M.

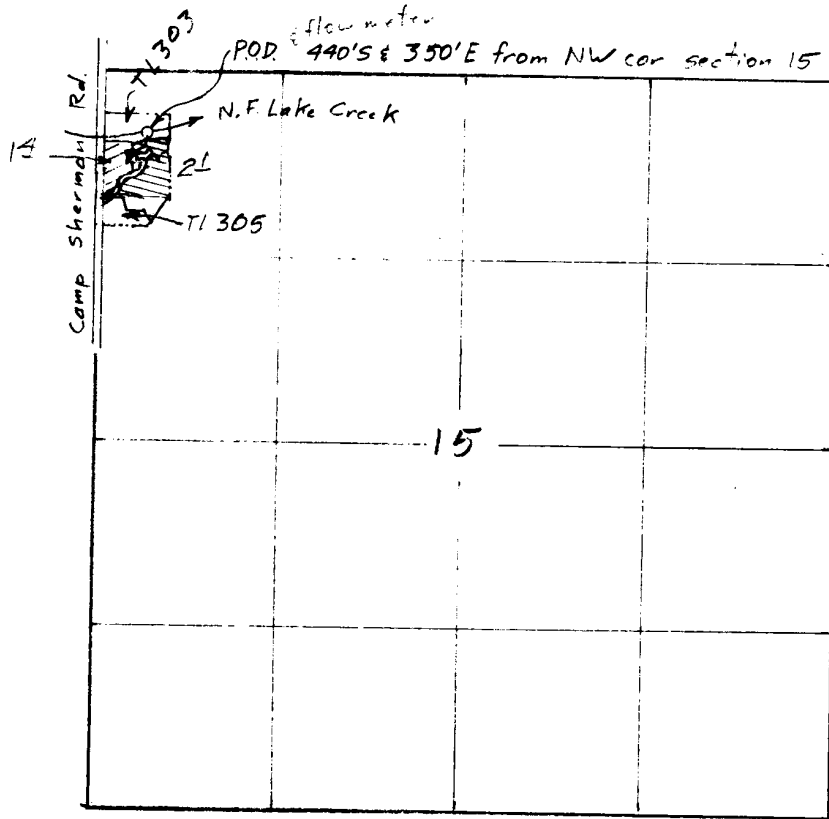


Scale 1" = 1320'  
(4" = 1 mile)

T-11964

RECEIVED

- ⊗ To: 1A acres
- ⊗ C-90290 2L acres (no change)

Claim of Beneficial Use Map  
for  
DAVID A. RICHENSTEIN

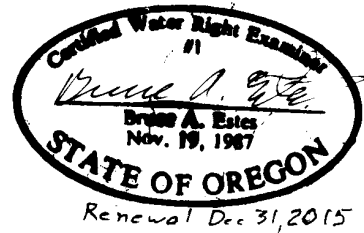

This map is for the purpose of locating a water right only and has no intent to provide legal dimensions or the location of property lines.

**ESTES SURVEYS, LLC**  
PO-Box-47819  
Salem, OR 97305-7519  
(503) 585-7883  
60382 Arnold Rd  
Bend, OR 97702  
(541) 382-7301