






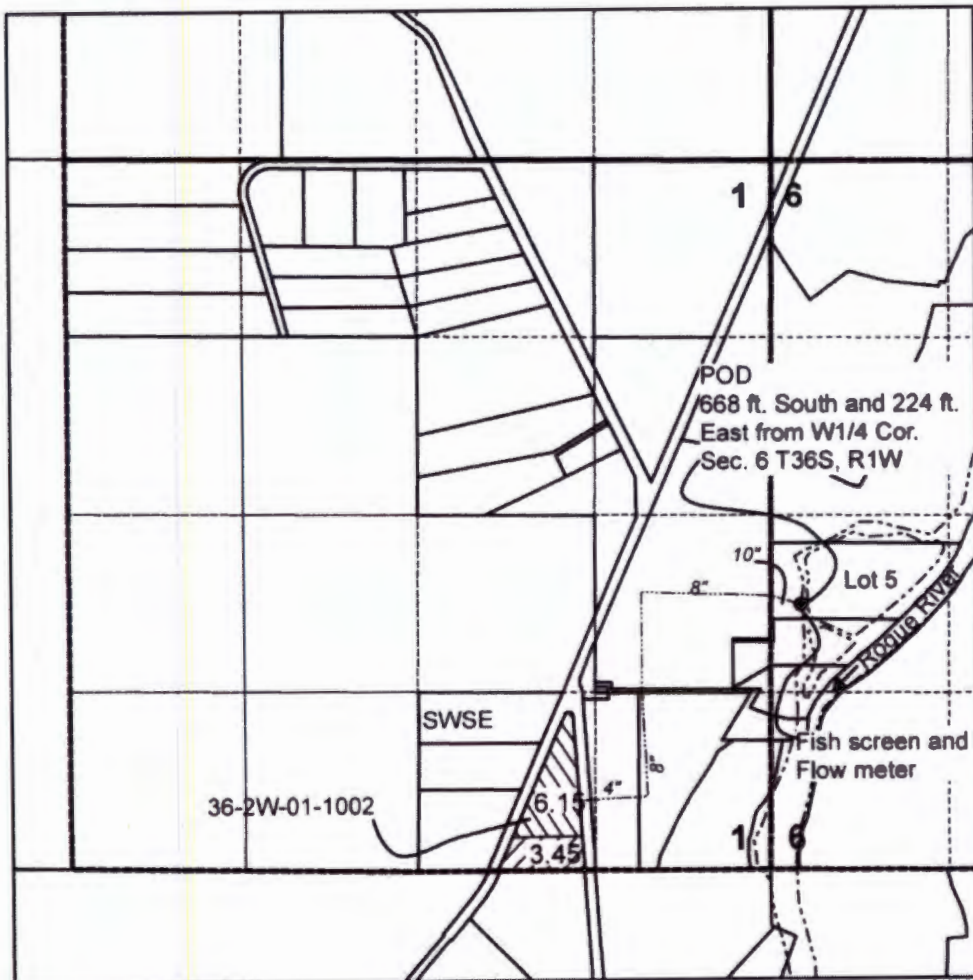

Map of Claim of Beneficial Use T 36 S, R 2 W, Sec. 1
Application S-87150
Permit S-54567
RRIP, Limited



Legend

-  Primary
-  Supplemental
-  Pipe line
-  Section line
-  Quarter-Quarter line
-  Rogue River



1 inch = 1,320 feet

RECEIVED BY OWRD

DEC 05 2016

SALEM, OR

This map is not intended to provide legal dimensions or locations of property ownership lines.

