


3

THIS MAP IS FOR THE PURPOSE OF IDENTIFYING THE LOCATION OF THE WATER RIGHT ONLY. THERE IS NO INTENT TO PROVIDE DIMENSIONS OR LOCATION OF PROPERTY OWNERSHIP LINES.

NW 1/4 SE 1/4

NE 1/4 SE 1/4

METER IS 1736 FEET NORTH AND WEST 2246 FEET FROM THE SE CORNER OF SECTION 3.

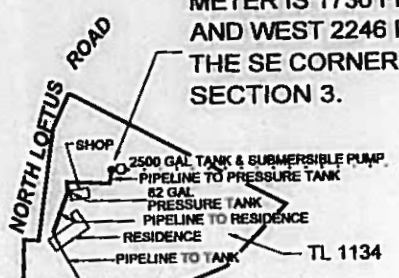

2246'

CLEAWOX LAKE

POD & FISH SCREEN POINT OF DIVERSION IS NORTH 1370 FEET AND WEST 2394 FEET FROM THE SE CORNER OF SECTION 3.

2394'

SW 1/4 SE 1/4

SE 1/4 SE 1/4

1736'
1370'

FD BRASS CAP

3 2
10 11

COBU MAP # 200A-7

FINAL PROOF SURVEY CLAIM OF BENEFICIAL USE WATER RIGHTS MAP

MID COAST BASIN UNDER

PERMIT 54947

APPLICATION NO S-87995

NW 1/4, SE 1/4, SEC 3, T19S, R12W, W.M.
SW 1/4, SE 1/4, SEC 3, T19S, R12W, W.M.
TAX MAP 19-12-03-4, T.L. 1134
LANE COUNTY, OREGON

FOR: MAX KUO
4884 N. LOFTUS RD
FLORENCE, OREGON 97439

PREPARED BY: WOBBE & ASSOCIATES, INC.
510 KINGWOOD ST. / P.O. BOX 3093
FLORENCE, OR 97439
DATE: AUGUST 7, 2019

RECEIVED
OCT 07 2019
OWRD

