

CLAIM OF BENEFICIAL USE MAP

App. # R-85062 Permit # R-13207, TAX LOT 200, CURRY COUNTY,
LOCATED IN TOWNSHIP 34 SOUTH, RANGE 15 WEST, SECTION 20 W.M.


THIS MAP WAS PREPARED FOR THE PURPOSE OF IDENTIFYING THE
LOCATION OF WATER RIGHT ONLY AND IS NOT INTENDED TO PROVIDE
LEGAL DESCRIPTIONS OR LOCATIONS OF PROPERTY OWNERSHIP LINES.

POINT OF DIVERSION LIES 382 FEET SOUTH AND 254 FEET WEST OF
THE WEST 1/4 CORNER OF SECTION 20 IN TOWNSHIP 24 SOUTH, RANGE
15 WEST W.M.

RESERVOIR HAS A TOTAL SURFACE AREA OF 1.99 ACRES, 1.51 ACRES
IN THE NW QUARTER OF THE SW QUARTER OF SECTION 20 AND
0.48 ACRES IN THE SW QUARTER OF THE NW QUARTER OF SECTION 20.

DAM HEIGHT MEASURED AT 6.9 FEET WITH OPERABLE OUTLET PIPE
CAPABLE OF EVACUATING STORED WATER.

ALL BEARING AND DISTANCES ARE BASED ON OREGON STATE PLANE
COORDINATE SOUTH ZONE, INTERNATIONAL FEET.

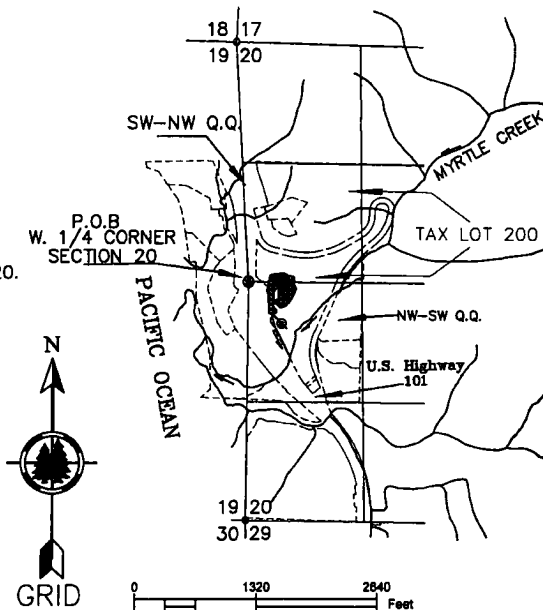

LEGEND

● POINT OF BEGINNING
(P.O.B.)

● POINT OF DIVERSION
(P.O.D.)

→ FLOW DIRECTION

■ RESERVOIR

— STREAM

----- TAX LOT LINES



EXPIRES 12/31/2017

Stuntzner
Engineering & Forestry, LLC

706 S. 4TH ST.
P.O. BOX 118
COOS BAY, OREGON 97420

PHONE: (541) 287-2872
FAX: (541) 287-0888
www.stuntzner.com

Engineering - Land Surveying - Forestry - Land Planning - Water Rights

JOB #: 117-198

DATE: 12/1/2017

DRAWN BY: MVC

CHECKED BY: RED

PREPARED FOR:

Oregon Parks and Recreation Department

P.O. Box 1345

Port Orford, OR 97301

FILE NAME: COBU_MAP_State_Permit.dwg

SHEET 1 OF 1