

# DAN McCARTY TRANSFER APPLICATION MAP ADDING ADDITIONAL POINT OF APPROPRIATION TO CERT'S 52005 & 50853 MORROW COUNTY T2N & T1N, R24E W.M.

**LEGEND**

PERMIT G-5238 CERT 50853



AREA INVOLVED IN THIS TRANSFER



AREA NOT INVOLVED IN TRANSFER

PERMIT G-5239 CERT 52005




AREA INVOLVED IN THIS TRANSFER



AREA NOT INVOLVED IN TRANSFER

TAX LOT BOUNDARY

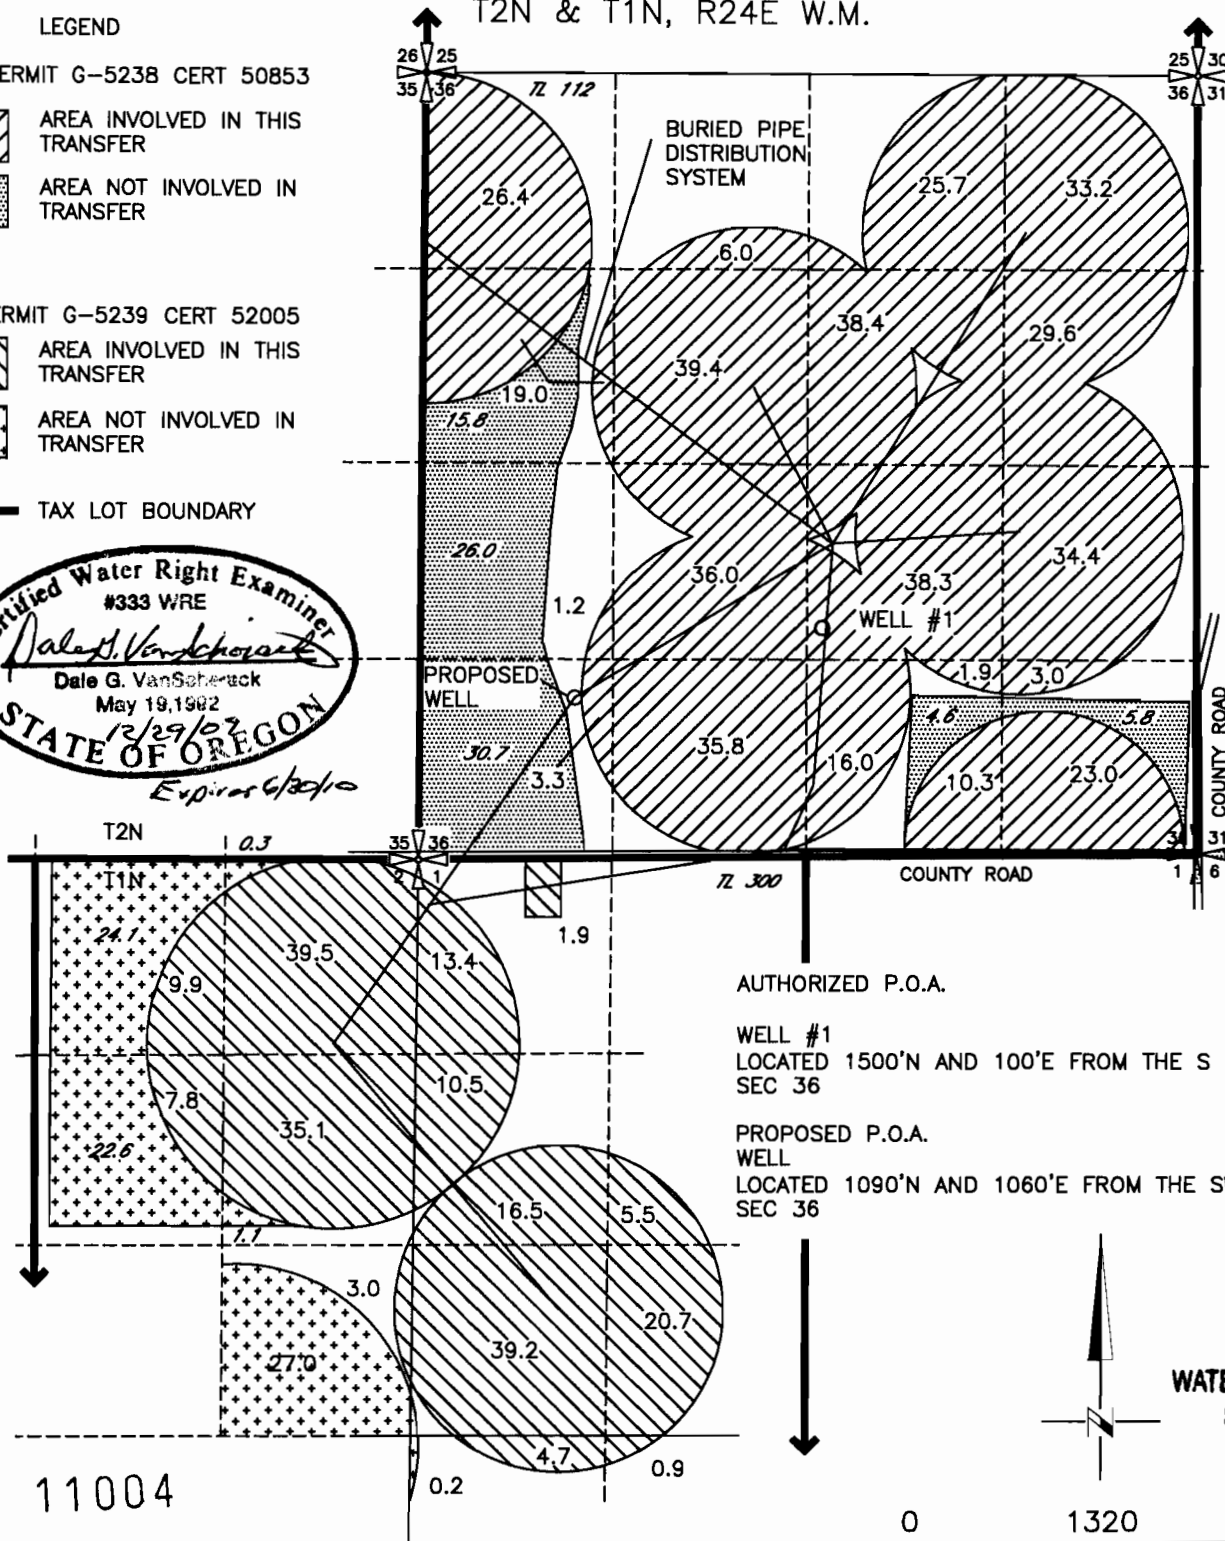

AUTHORIZED P.O.A.



WELL #1  
 LOCATED 1500'N AND 100'E FROM THE S 1/4 COR  
 SEC 36

PROPOSED P.O.A.  
 WELL  
 LOCATED 1090'N AND 1060'E FROM THE SW COR  
 SEC 36

**RECEIVED**

JAN 11 2010

WATER RESOURCES DEPT  
 SALEM, OREGON

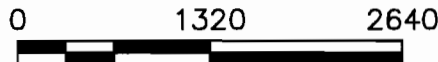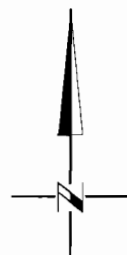


SCALE IN FEET

NOTE:  
 THE PURPOSE OF THIS MAP IS TO IDENTIFY THE APPROXIMATE LOCATION  
 OF THE WATER RIGHT. IT IS NOT INTENDED TO PROVIDE INFORMATION  
 RELATIVE TO THE LOCATION OF PROPERTY OWNERSHIP BOUNDARY LINES.

T 11004

T. 2N. R. 24E. W.M.

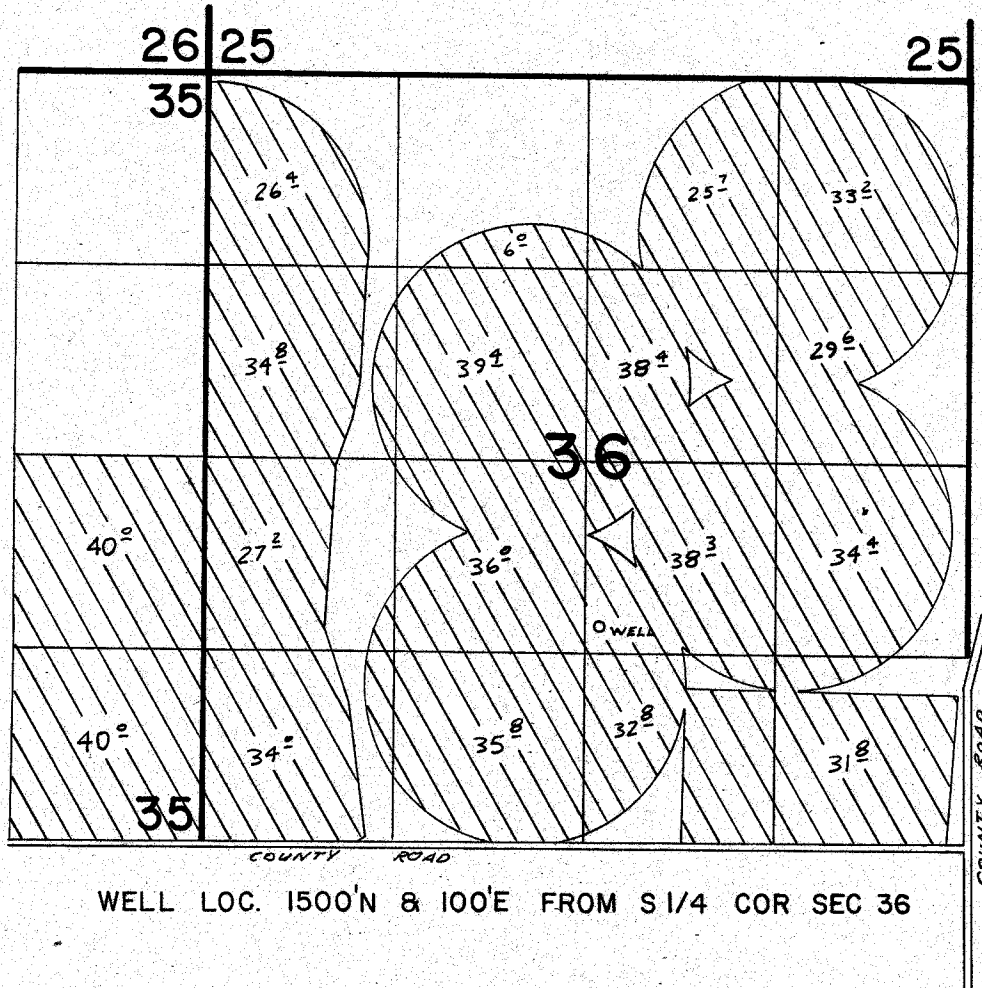

**FINAL PROOF SURVEY**  
UNDER

Application No. G-6342 Permit No. G-5238  
IN NAME OF

ERIC ANDERSON

Surveyed 10-25 1978, by R. BARVILY