

CLAIM OF BENEFICIAL USE

APPLICATION R-72269

PERMIT R-12625

APPLICATION S-72266

PERMIT S-53525

Prepared for:

Brad Boucher
2300 Colestin Road
Ashland, OR 97520


T 41 S, R 1 E, WM.
JACKSON COUNTY, OREGON

RECEIVED BY OWRD

AUG 17 2017

SALEM, OR

Base Map - Jackson County GIS tax lots adjusted & oriented to Partition Plat P-42-1995 & survey map 8992 over Oregon Map aerial photo downloaded April 13, 2016 & Google aerial photo dated July 27, 2016 for assumed best fit

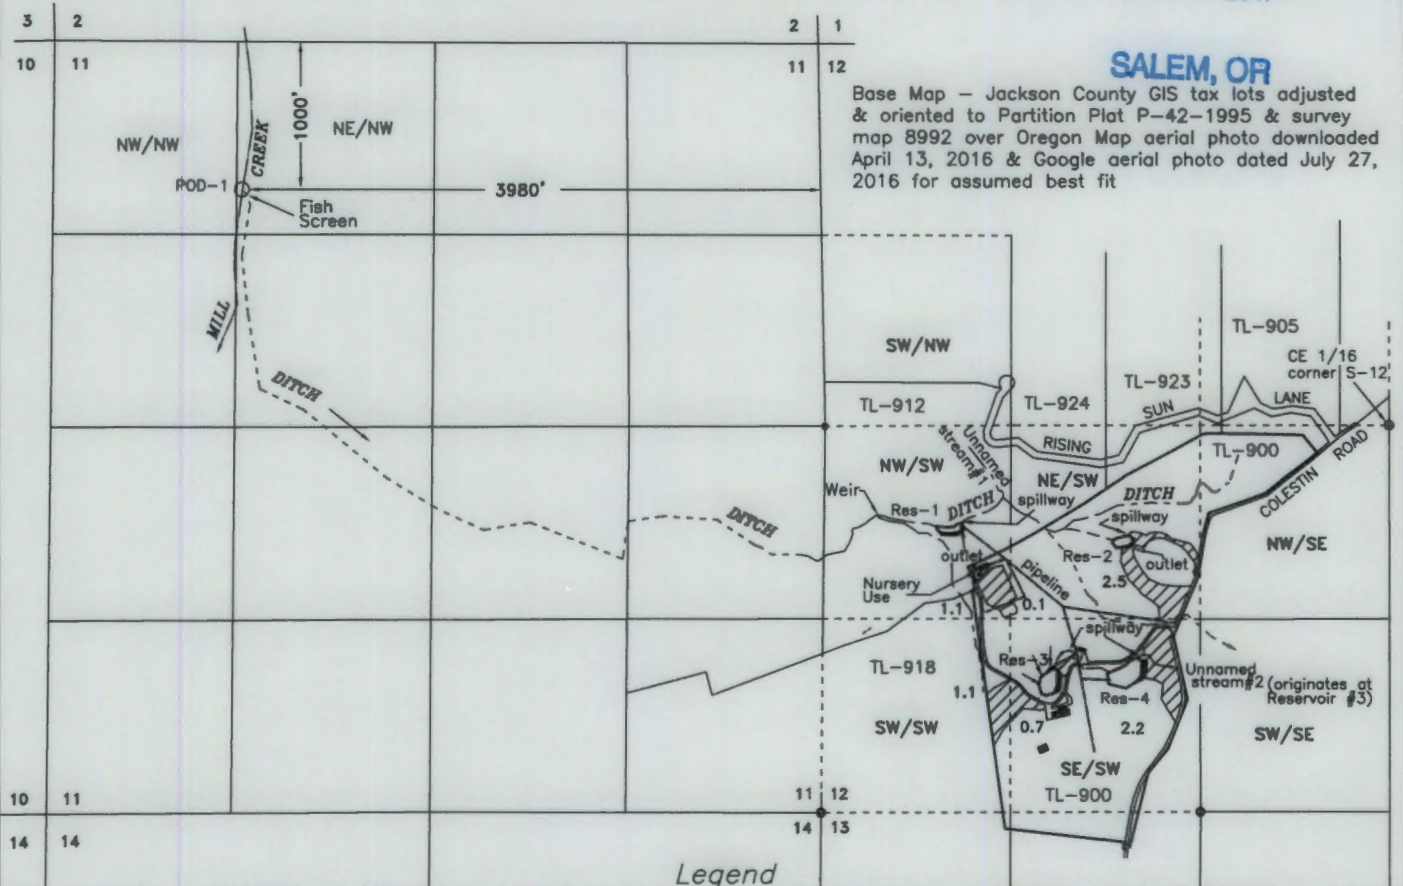

POD-1 Mill Creek - 1000 feet south & 3980 feet east from the NE corner section (from FPS permit S-44755)

- Res-1 Outlet - NW/SW Section 12, 700 feet South & 2930 feet west from the CE 1/16 corner Section 12
0.3 AF - Source - Diffuse runoff & runoff collected in unnamed ditch & Mill Creek
- Res-2 Outlet - NE/SW Section 12, 820 feet South & 1775 feet west from the CE 1/16 corner Section 12
0.5 AF - Source - Unnamed stream #1, year round
- Res-3 Dam - SE/SW Section 12, 1750 feet South & 2270 feet west from the CE 1/16 corner Section 12
1.0 AF - Source - Unnamed stream #2, year round
- Res-4 Dam - SE/SW Section 12, 1670 feet South & 1680 feet west from the CE 1/16 corner Section 12
2.3 AF - Source - Unnamed stream #2, year round

Supplemental irrigation - 7.7 Acres
Source Reservoirs 1,2,3,4 (4.1 AF)

0.03 Acre - Nursery Operations - Source Mill Creek & Reservoir 1, (0.3 AF year round)

Buildings

SCALE: 1" = 1320'

0' 660' 1320' 2640'

Prepared by:

FARBER & SONS, INC.
dba FARBER SURVEYING
(541) 664-5599

PO BOX 5286
431 OAK STREET
CENTRAL POINT, OREGON 97502

DATE: June 22, 2017 ned



RENEWS: 12/31/2017

This map is not intended to provide legal dimensions or locations of property ownership lines

Job No. 1999-843