


**Map of
Claim of Beneficial Use
John and Susan Albertson
Application G-16698
Permit G-16464**

RECEIVED
MAY 07 2020
OWRD

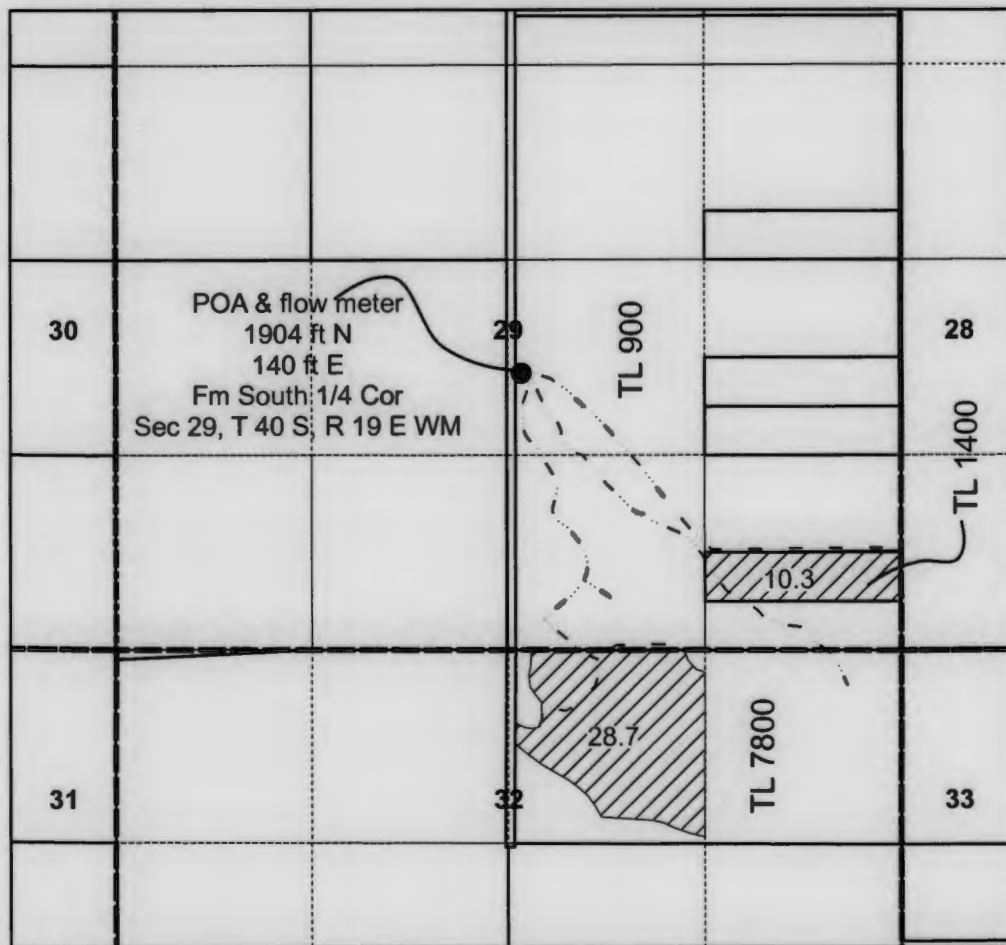


Legend

- Well Lake 51749
- - Irrigation ditch
- ▨ Irrigated area



1 inch = 1,320 feet

Note: This map is not intended to provide legal dimensions or locations of property ownership lines.

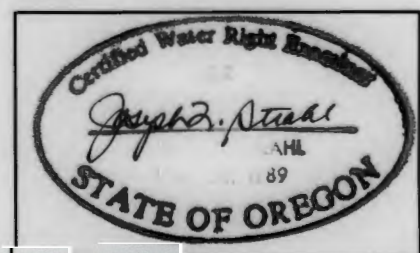

CWRB # 222