


RECEIVED

JUL 12 2016

WATER RESOURCES DEPT
SALEM, OREGON

Map to Accompany Claims of Beneficial Use Under
Appl.# R-87055, R-87056, G-16977 & G-16978
Permits R-14582, R-14583, G-16459 & G-16460
In the Names of Steve Dorn & Don Farrelly

T.3 S., R.3 E., WM
Sections 16 & 21

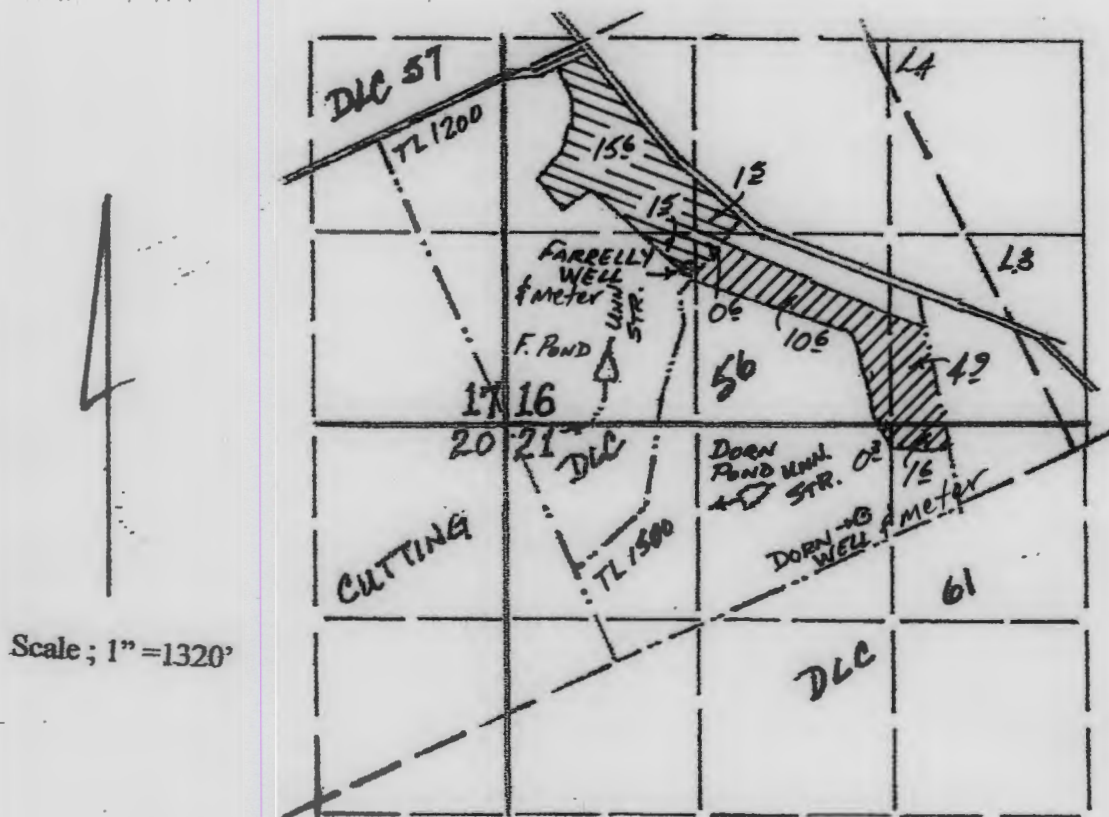

Farrelly Permit G-16460



Dorn Permit G-16459



POD's Located: Farrelly Pond - 440' N & 3170' W;
Farrelly Well - 1240' N & 2600' W;
Dorn Pond - 370' S & 2240' W;
Dorn Well - 460' S & 1240' W; all from the SE Corner Cutting DLC 56.

This map is for the purpose of identifying the location of water rights only, and is not
Intended to provide legal dimensions or locations of property lines.