


Claim of Beneficial Use Map under Permit G-16264
 T 37 S, R 4 W, W M, Jackson County
 Portions of Section 31
 August 3, 2016

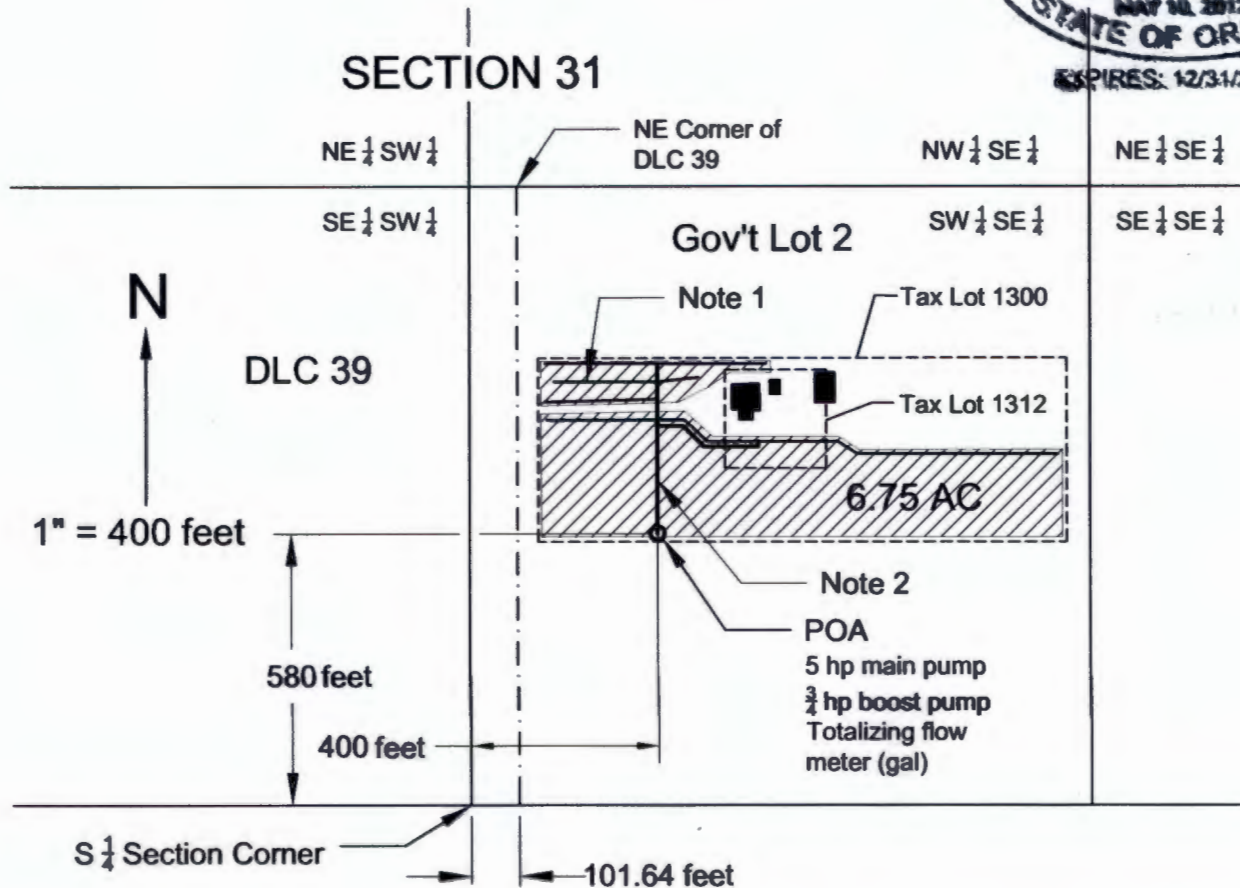

 **6.75 acres irrigated under Application File No. G-16701 and Permit G-16264 with Date of Priority July 24, 2006.**

POA Point of Appropriation (POA) is 580 feet N & 400 feet E of South $\frac{1}{4}$ Section Corner of Section 31.

 Structures

Note 1 2.0, 1.5, 1.25, 1.0 inch dia. buried PVC pipe feeding sprinklers providing irrigation to lawn.

Note 2 2.0, 1.5 inch dia. buried PVC pipe feeding above ground 0.5 inch drip lines providing irrigation to grape vines.

This map was drawn by Steven P. Boyd (CWRE# 85312) for Gary and Cassie Conner (owners of Tax Lots 1300 & 1312) to support their Claim or Beneficial Use for irrigation.

NOTE: This map is not intended to provide legal dimensions or locations of property ownership lines.

SALEM, OR

AUG 15 2016

RECEIVED BY CWR