



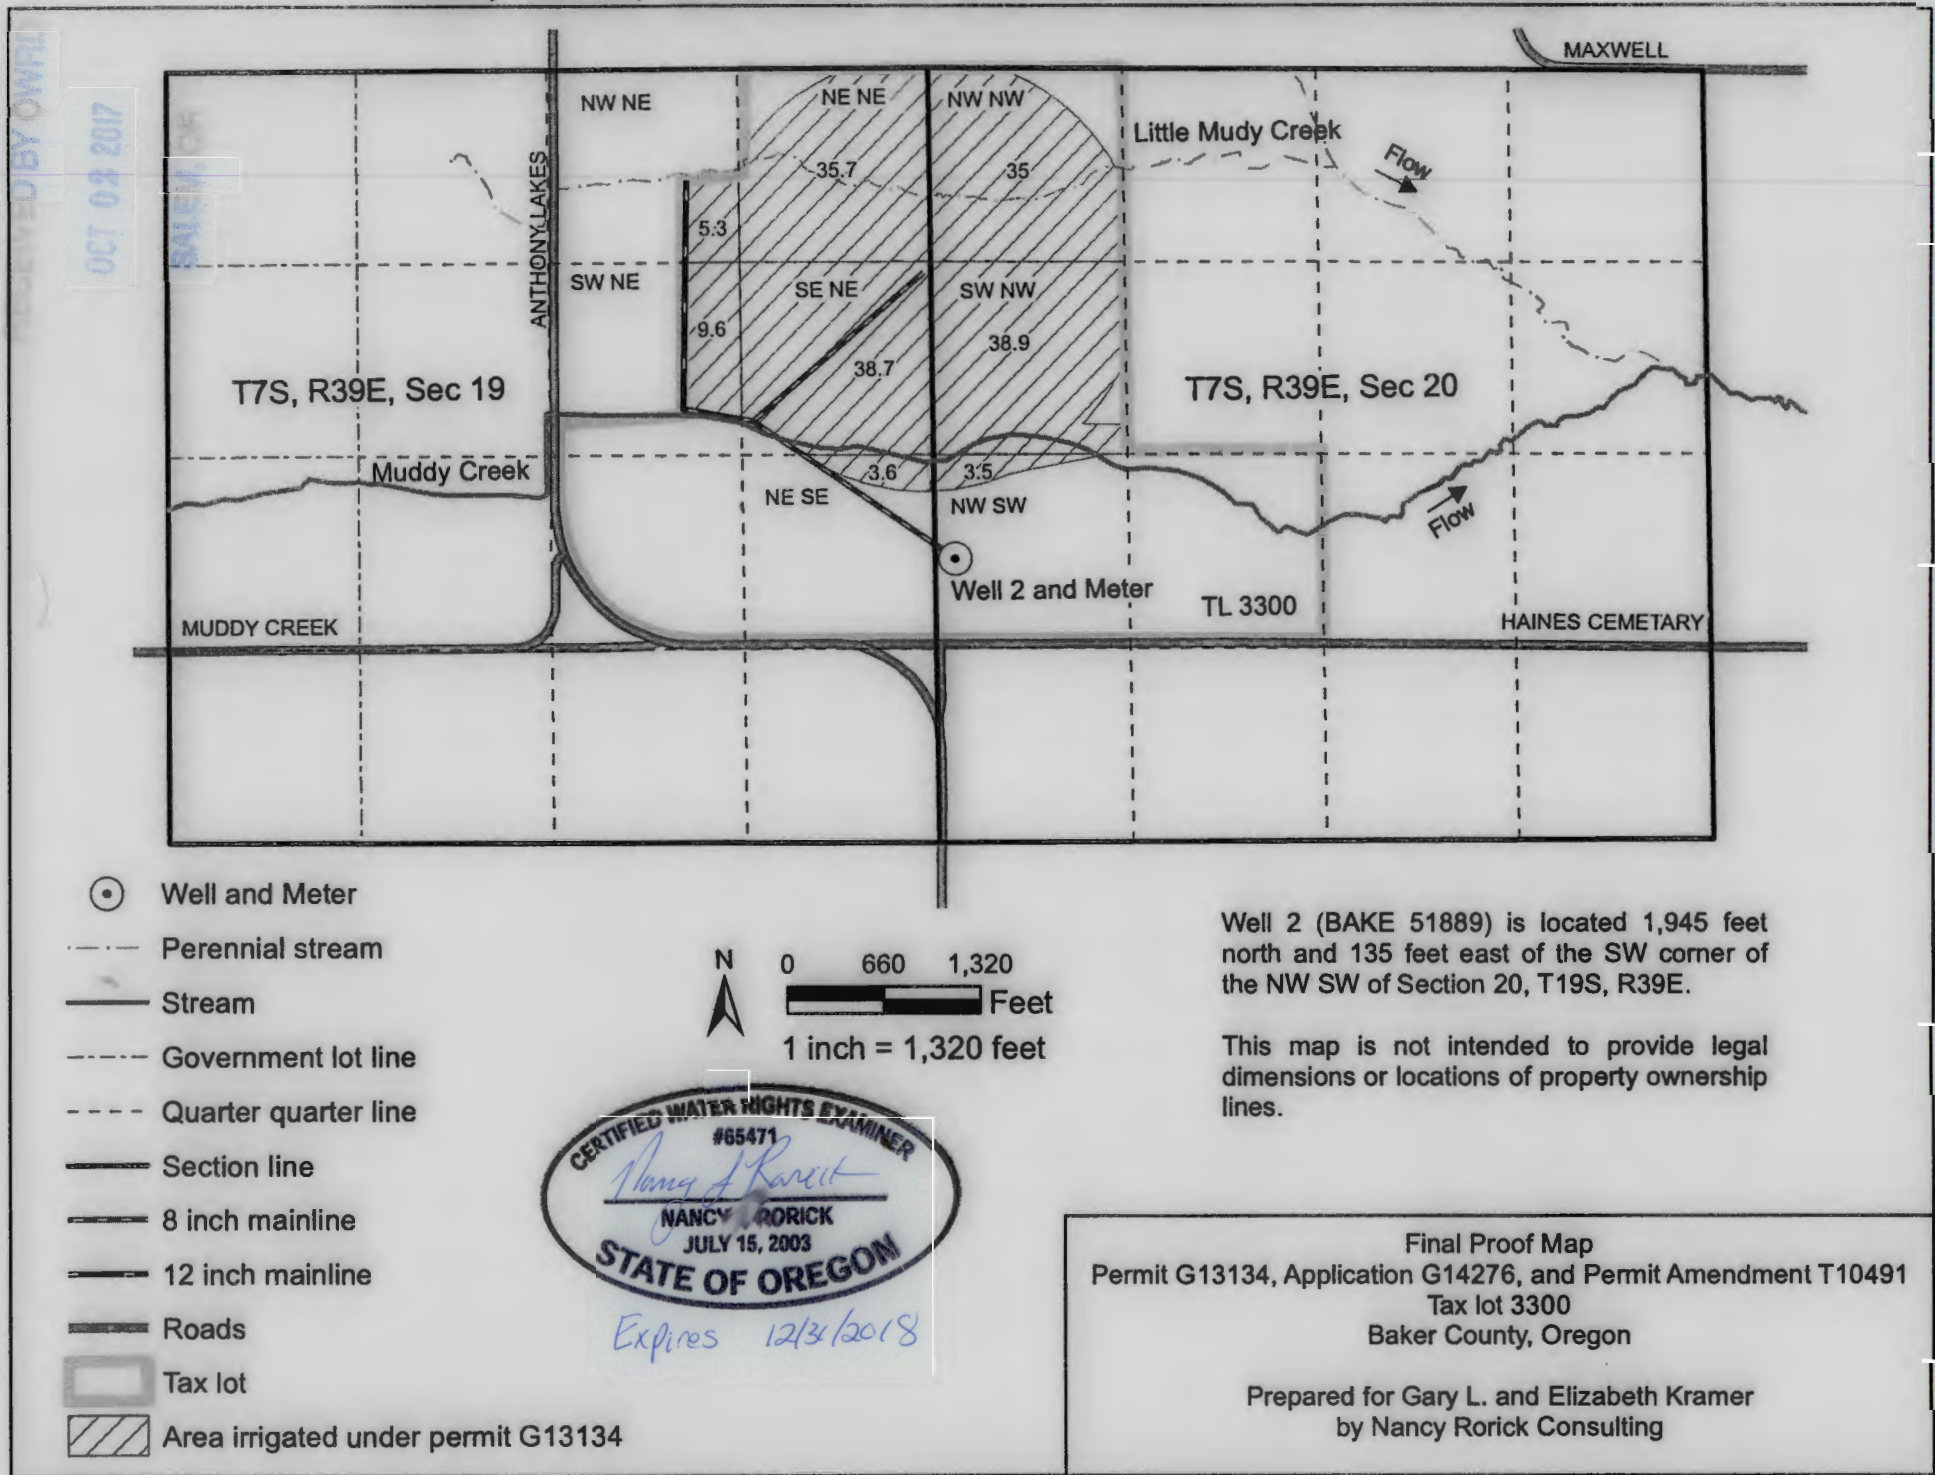

RECEIVED BY OWRI
OCT 04 2017