




T.6S. R.2W. Sec. 15 & 16, W.M.

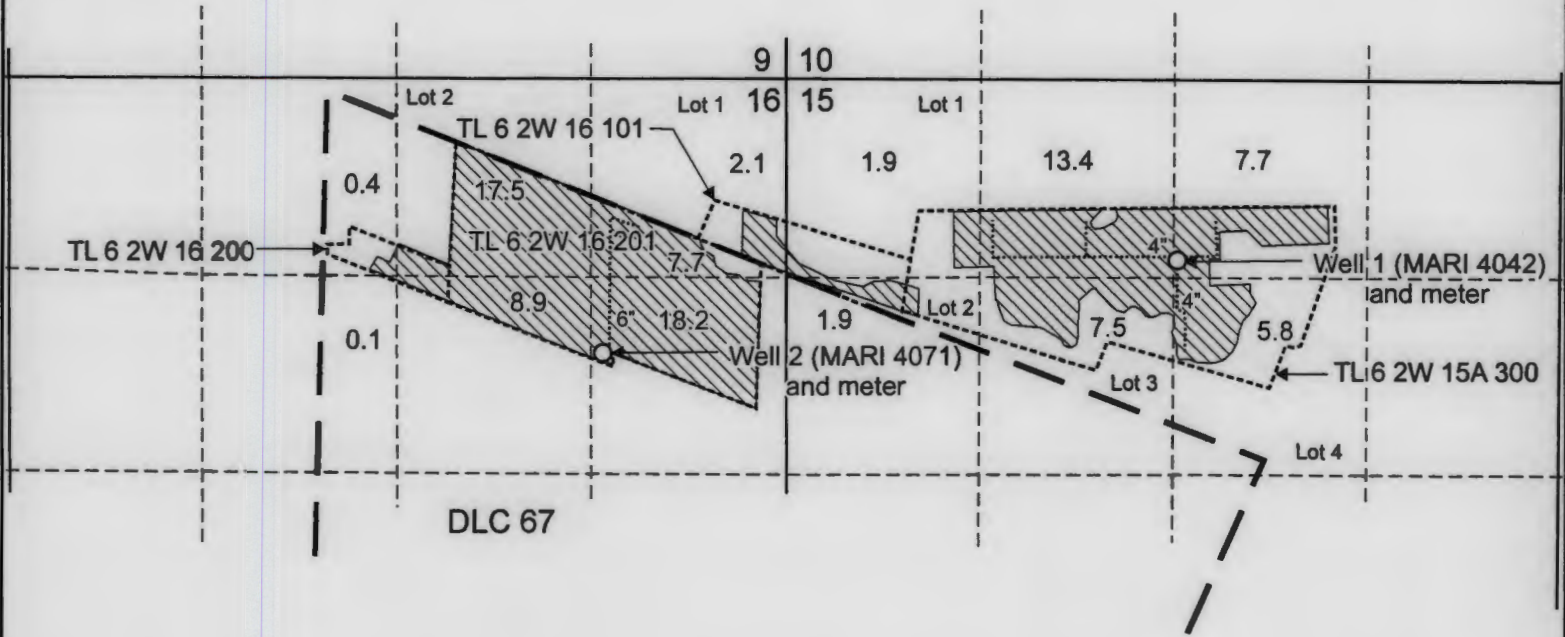

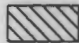

Well 1 (MARI 4042) and the meter are located 1,230 feet south and 20 feet east from the N 1/4 corner, Section 15.

Well 2 (MARI 4071) and the meter are located 1,870 feet south and 1,255 feet west from the NE corner, Section 16.

 Area (93.1 Acres) of nursery use under Application G-15669, Permit G-15392.

 Buried PVC Mainline


 Tax Lot Boundary

 Donation Land Claim (DLC) Boundary

RECEIVED

MAR

PT

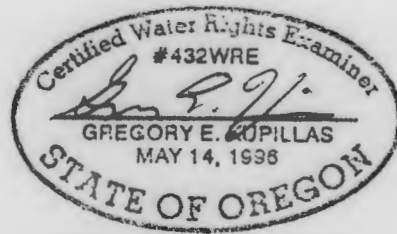

EXPIRATION DATE: 6/30/2017



Scale: 1" = 1,320'



This map was prepared for the purpose of identifying the location of a water right only and is not intended to provide legal dimensions or location of property ownership lines.

Claim of Beneficial Use Map
Application G-15669, Permit G-15392

Frank Henry
T.6S. R.2W. Sec. 15 & 16, W.M.