


T.2S. R.5E. Section 17, W.M.

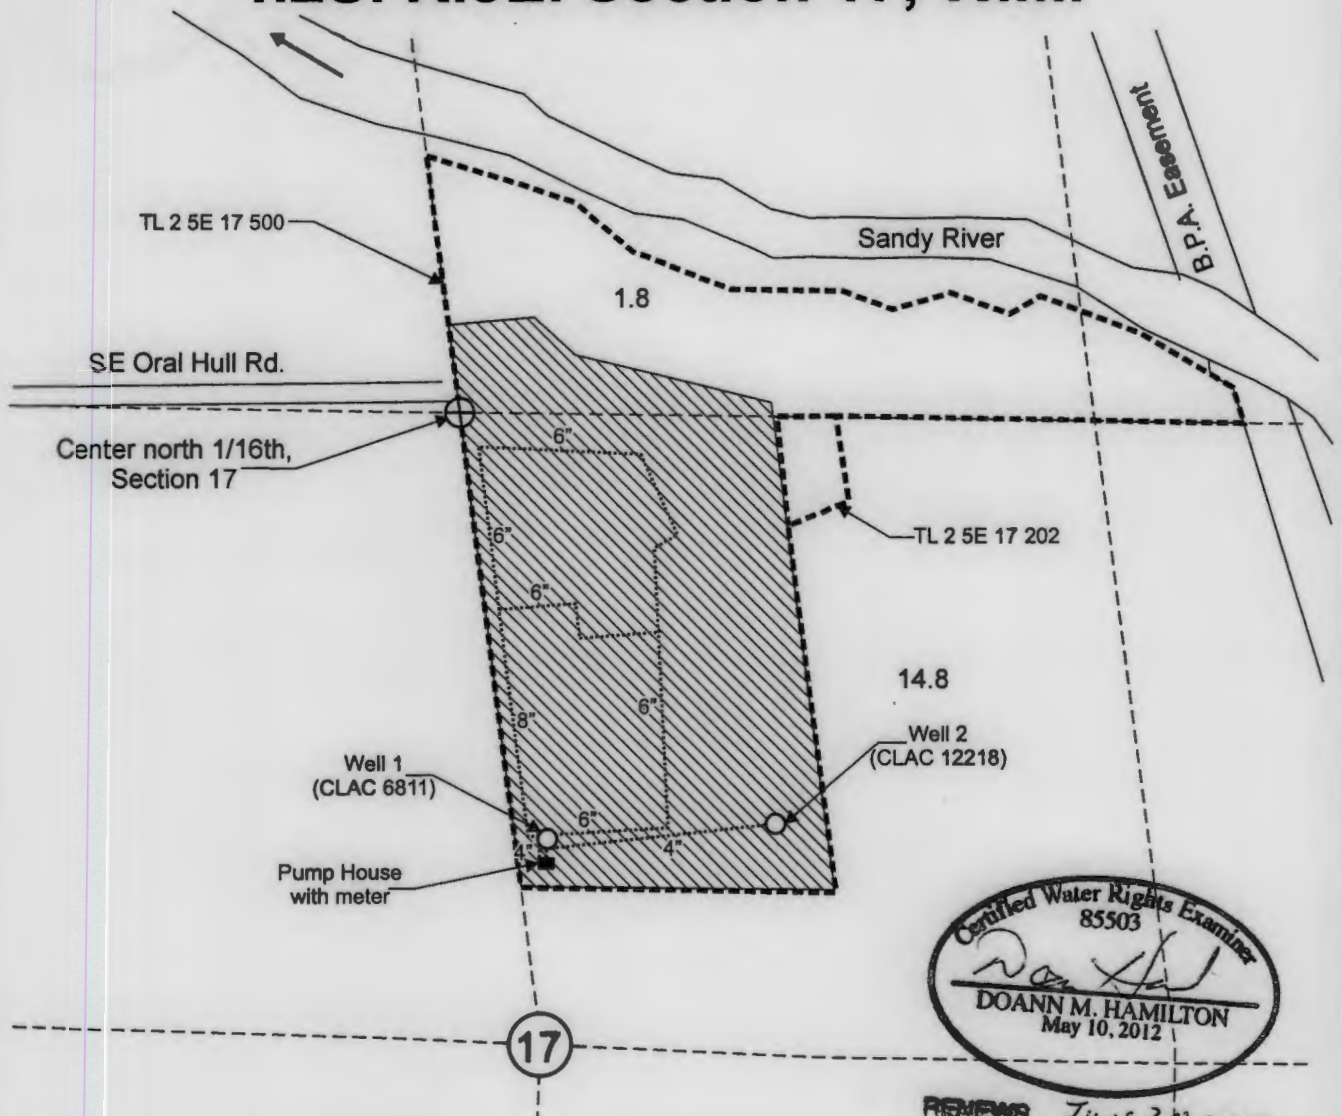

RENEWS June 30, 2017

Well 1 (CLAC 6811) is located 890 feet south and 185 feet east from the center north 1/16th corner, Section 17.


Well 2 (CLAC 12218) is located 860 feet south and 660 feet east from the center north 1/16th corner, Section 17.

Area (16.6 Acres) irrigated under Application G-14424, Permit G-13386.

Tax lot boundary

Mainlines for irrigation and commercial use

Scale: 1" = 400'

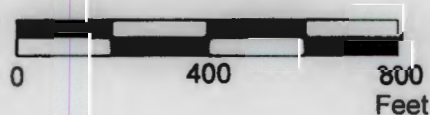

RECEIVED

MAR 04 2016

WATER RESOURCES DEPT
SALEM, OREGON

This map was prepared for the purpose of identifying the location of a water right only and is not intended to provide legal dimensions or location of property ownership lines.

Claim of Beneficial Use Map
Application G-14424, Permit G-13386

Oral Hull Foundation for the Blind, Inc.
T.2S. R.5E. Section 17, W.M.

Pacific Hydro-Geology Inc.

02/2016

Oral Hull COBU.cdr