


# T.2S.R.2W.W.M.

Certificate 20143

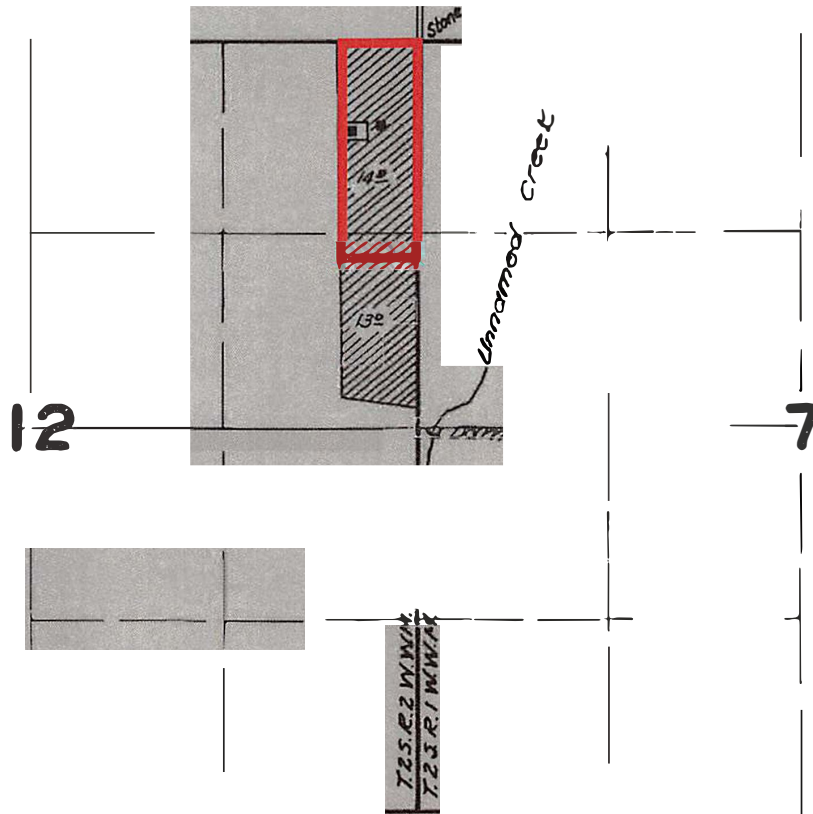


17.9 acres to be voluntarily cancelled shown in red. Cancel all of TX 100: 14.8 ac in NENE; 3.1 ac SENE

## FINAL PROOF SURVEY UNDER

Application No. 25409 Permit No. 19895  
IN NAME OF

FRED L. GRABORN

Surveyed .. 5 / 1 .. 1952, by .. L. COLEMAN

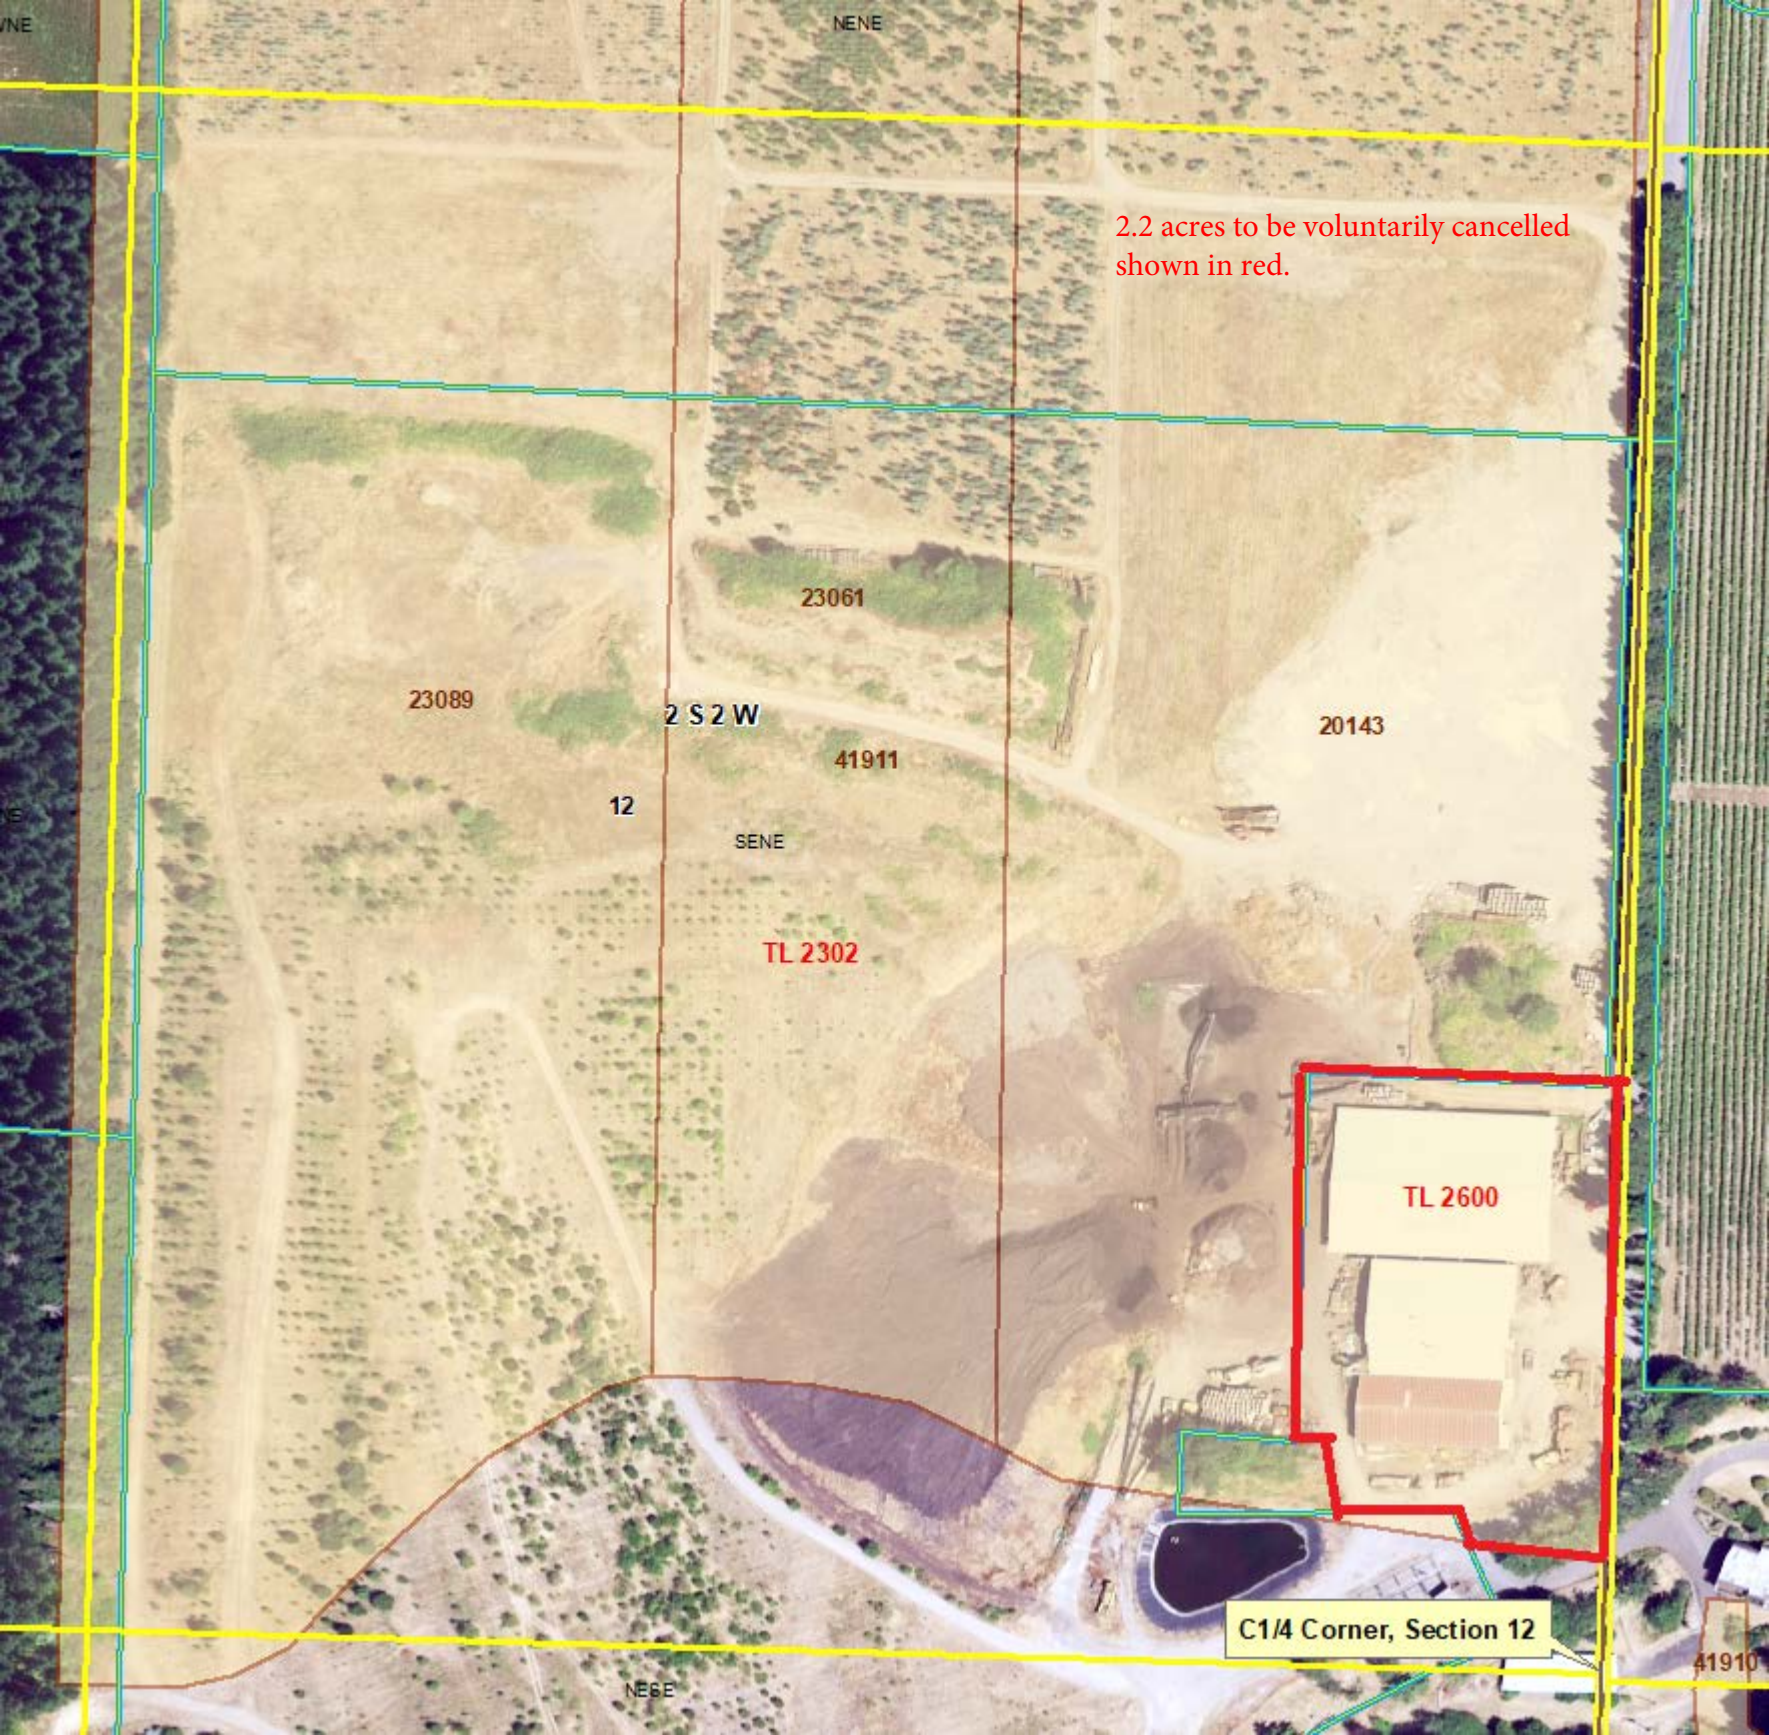

NENE

2.2 acres to be voluntarily cancelled  
shown in red.

23089

2 S 2 W

23061

20143

41911

12

SENE


TL 2302

TL 2600

C1/4 Corner, Section 12

NESE

41910

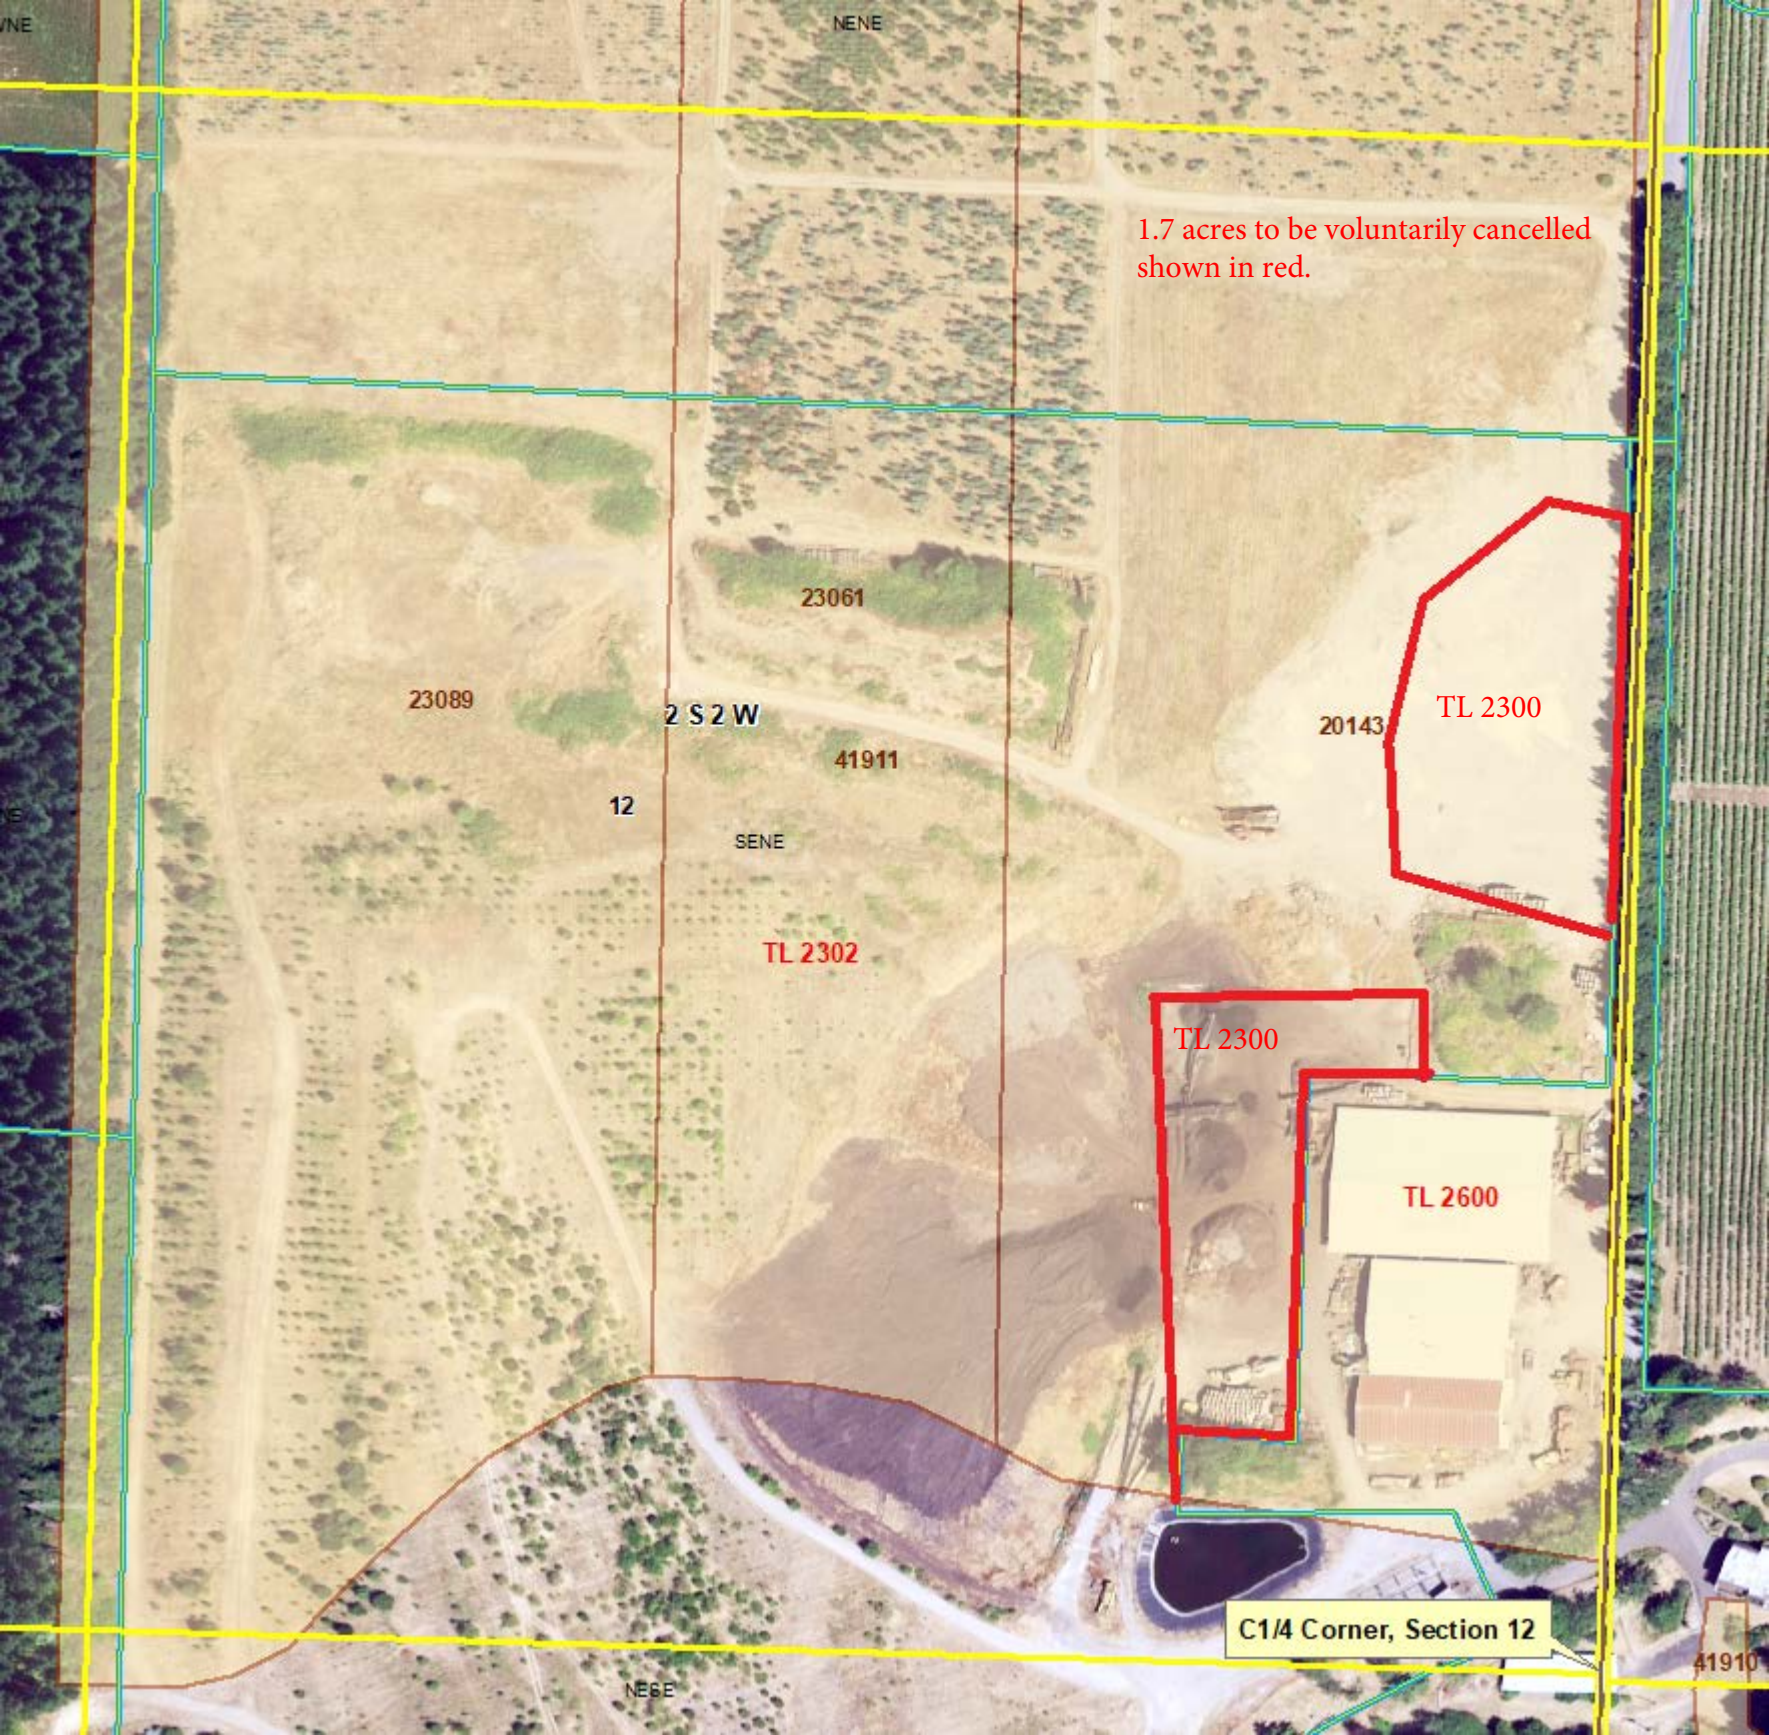

1.7 acres to be voluntarily cancelled  
shown in red.

23089

23061

41911

20143

TL 2300

2 S 2 W

12

SENE

TL 2302

TL 2300

TL 2600

C1/4 Corner, Section 12

NESE

41910