


T.2S., R.2W., W.M.

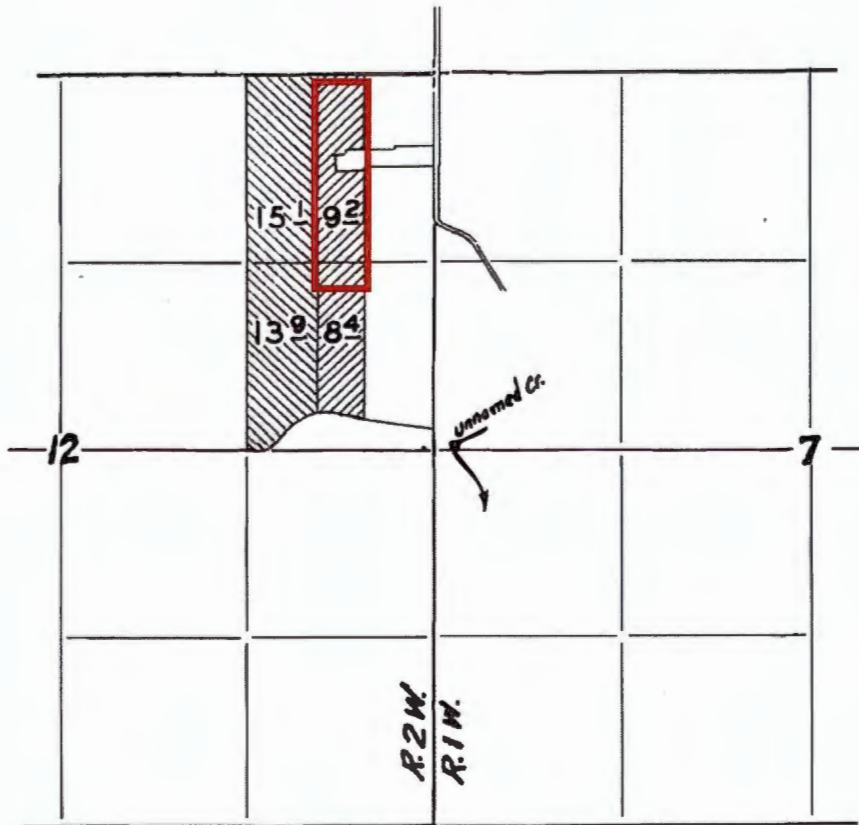

Certificate 23061: 9.2 acres NENE; 8.4 acres SENE

10.7 acres to be voluntarily cancelled shown in red. Cancel all TL 100; 9.2 acres NENE; 1.5 acres SENE

Remaining Right: 6.9 acres SENE

### FINAL PROOF SURVEY

UNDER

26859

21093



Cert 23061

Application No. 27890. Permit No. 21968.



Cert 23089

IN NAME OF

.....FRED B. GRABHORN.....

Surveyed 5 - 10, 1956 by M. BISH.....