


T.2S., R.2W., W.M.

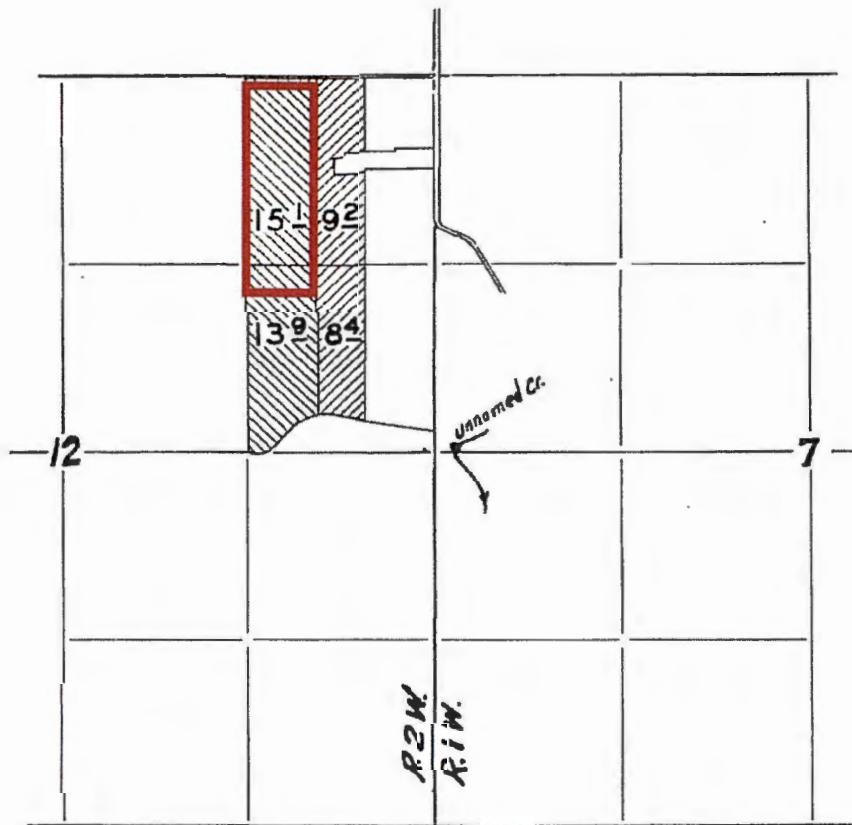

Certificate 23089:
15.1 acres NENE
13.9 acres SENE

17.5 acres to be voluntarily
cancelled shown in red.

Cancel all TL 100: 15.1
acres in NENE; 2.4
acres SENE

Remaining Right: 11.5
acres SENE

FINAL PROOF SURVEY

UNDER


26859

21093



Certificate 23061

Application No. 27890 Permit No. 21968

 

Certificate 23089

IN NAME OF

FRED B. GRABHORN

Surveyed 5 - 10, 1956 by M. BISH