

# FINAL PROOF MAP


TO CHANGE A POINT OF APPROPRIATION  
AND PLACE OF USE FOR TRANSFER T-8925  
3J FAMILY FARMS

RECEIVED

NOV 16 2020

OWRD

TOWNSHIP 26 SOUTH, RANGE 18 EAST, SECTION 14, W.M.  
TAX LOTS: 200, 201, & 202

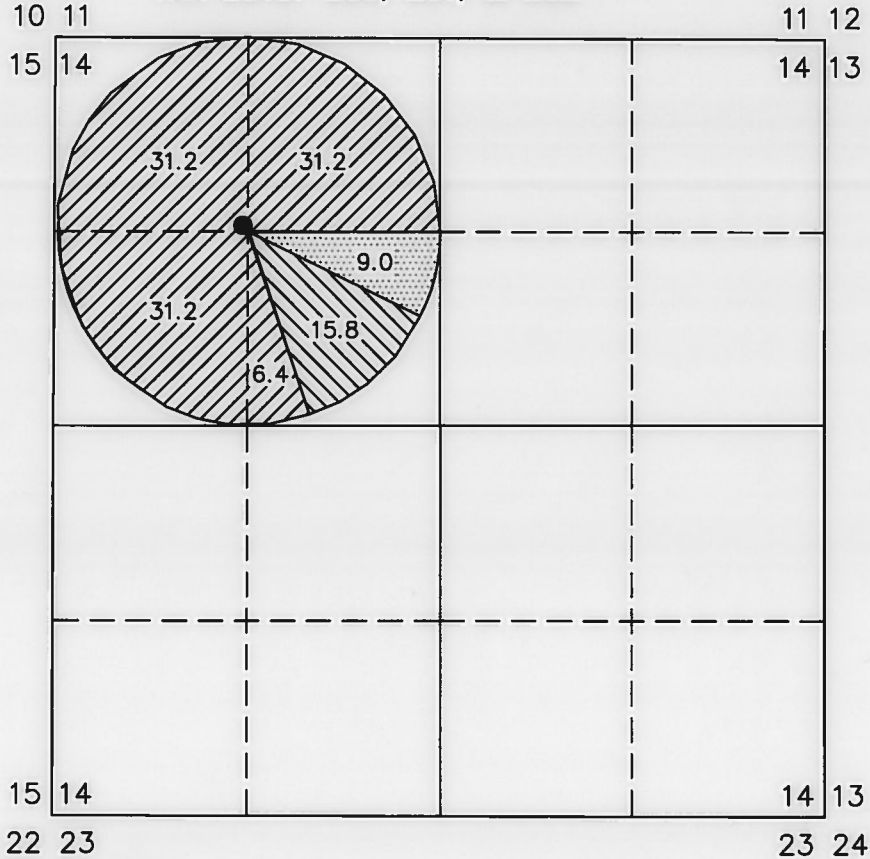

**WELL (LAKE 51228)**

- LOCATED IN THE SW 1/4 NW 1/4 SECTION 14, T26S R18E, W.M. AND 1340 FEET SOUTH AND 1341 FEET WEST FROM THE N 1/4 CORNER OF SAID SECTION.

FLOW METER IS LOCATED ON VERTICAL PIVOT PIPE 14' NORTH FROM THE WELL.




15.8 ACRES PRIMARY RIGHTS FROM WELL (G-9167), AS SHOWN.



100.0 ACRES PRIMARY RIGHTS FROM WELL (G-9064), AS SHOWN.




9.0 ACRES PRIMARY RIGHTS FROM WELL (G-10925), AS SHOWN.

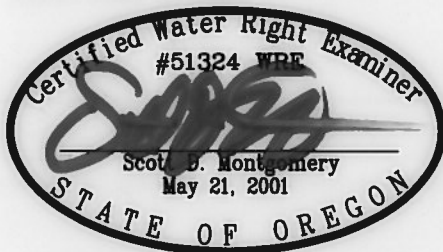

RENEWAL DATE: 12/31/2020

THIS MAP IS FOR THE PURPOSE OF LOCATING A WATER RIGHT ONLY AND HAS NO INTENT TO PROVIDE LEGAL DIMENSIONS OR THE LOCATION OF PROPERTY LINES.

<p>PREPARED FOR:</p> <p>3J FAMILY FARMS P.O. BOX 12 CHRISTMAS VALLEY, OR 97641</p>	<p>PREPARED BY:</p>  <p>ALL POINTS ENGINEERING AND SURVEYING, INC. P.O. BOX 767 (541) 548-5833</p> <p>TERREBONNE, OR 97760 www.APEandS.com</p>
--	---