


T.6S. R.5W. W.M.

POLK COUNTY, OREGON

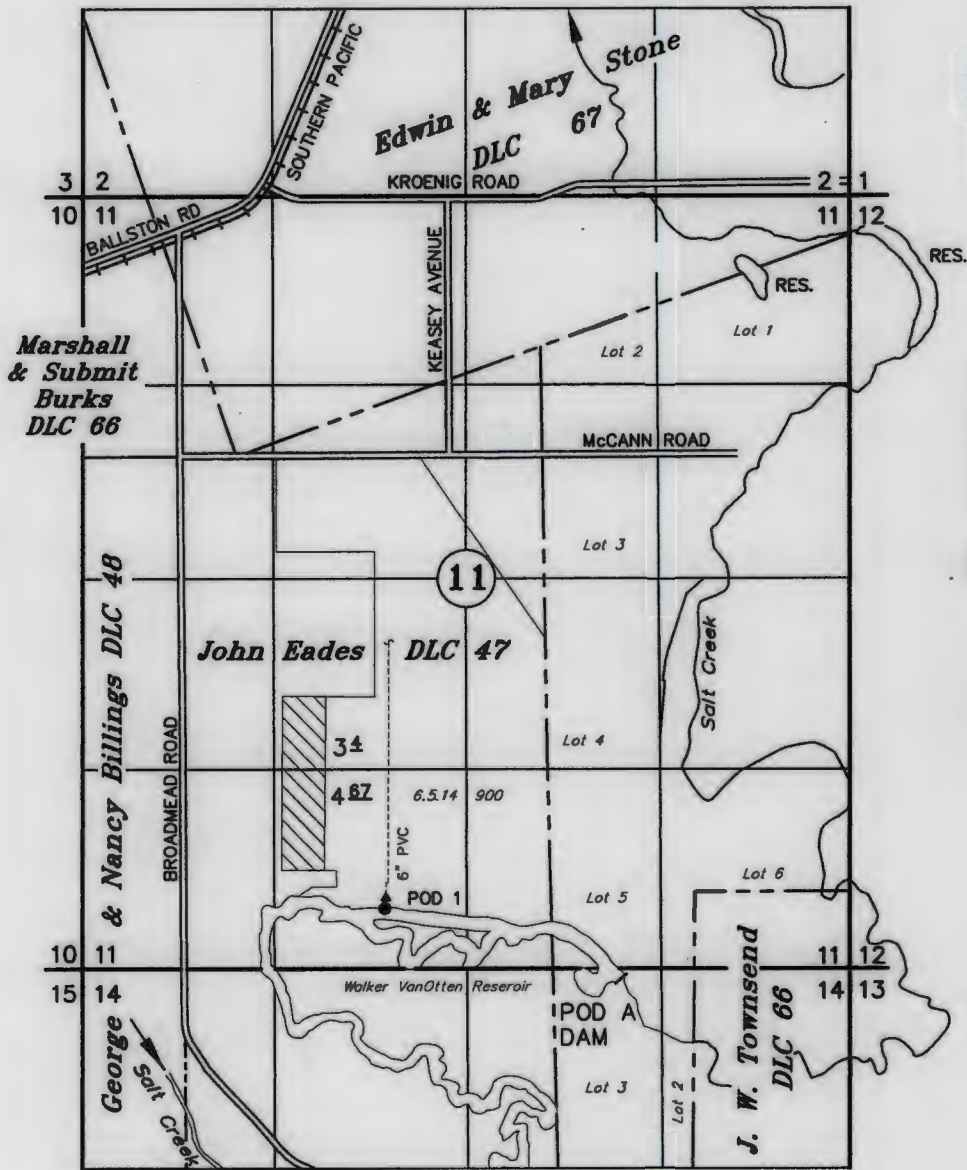

TAX LOT
6.5.11 900

RECEIVED

SEP 21 2020

OWRD

- POD 1: 2228' NORTH & 1405' EAST SW COR. JOHN EADES DLC 47
- ▲ METER: 7' NORTH OF PUMP ON ABOVE GROUND PORTION OF PERMANENT BURIED PIPELINE

Claim of Beneficial Use

PLACE OF USE


Transfer No. T-13278

BROADMEAD, LLC

September 8, 2020

SCALE 1" = 1320'

NOTE: This map is for the purpose of identifying the location of water rights and has no intent to dimension or locate property ownership lines.

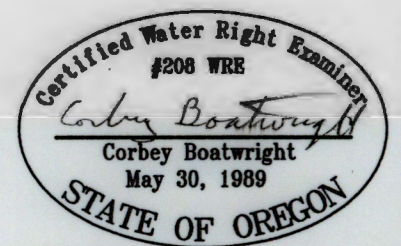

Renewal Date: 12-31-2021