


SECTION

2

Per 10137
9547

TOWNSHIP 5 S, RANGE 33 1/2 E, W. M.

North

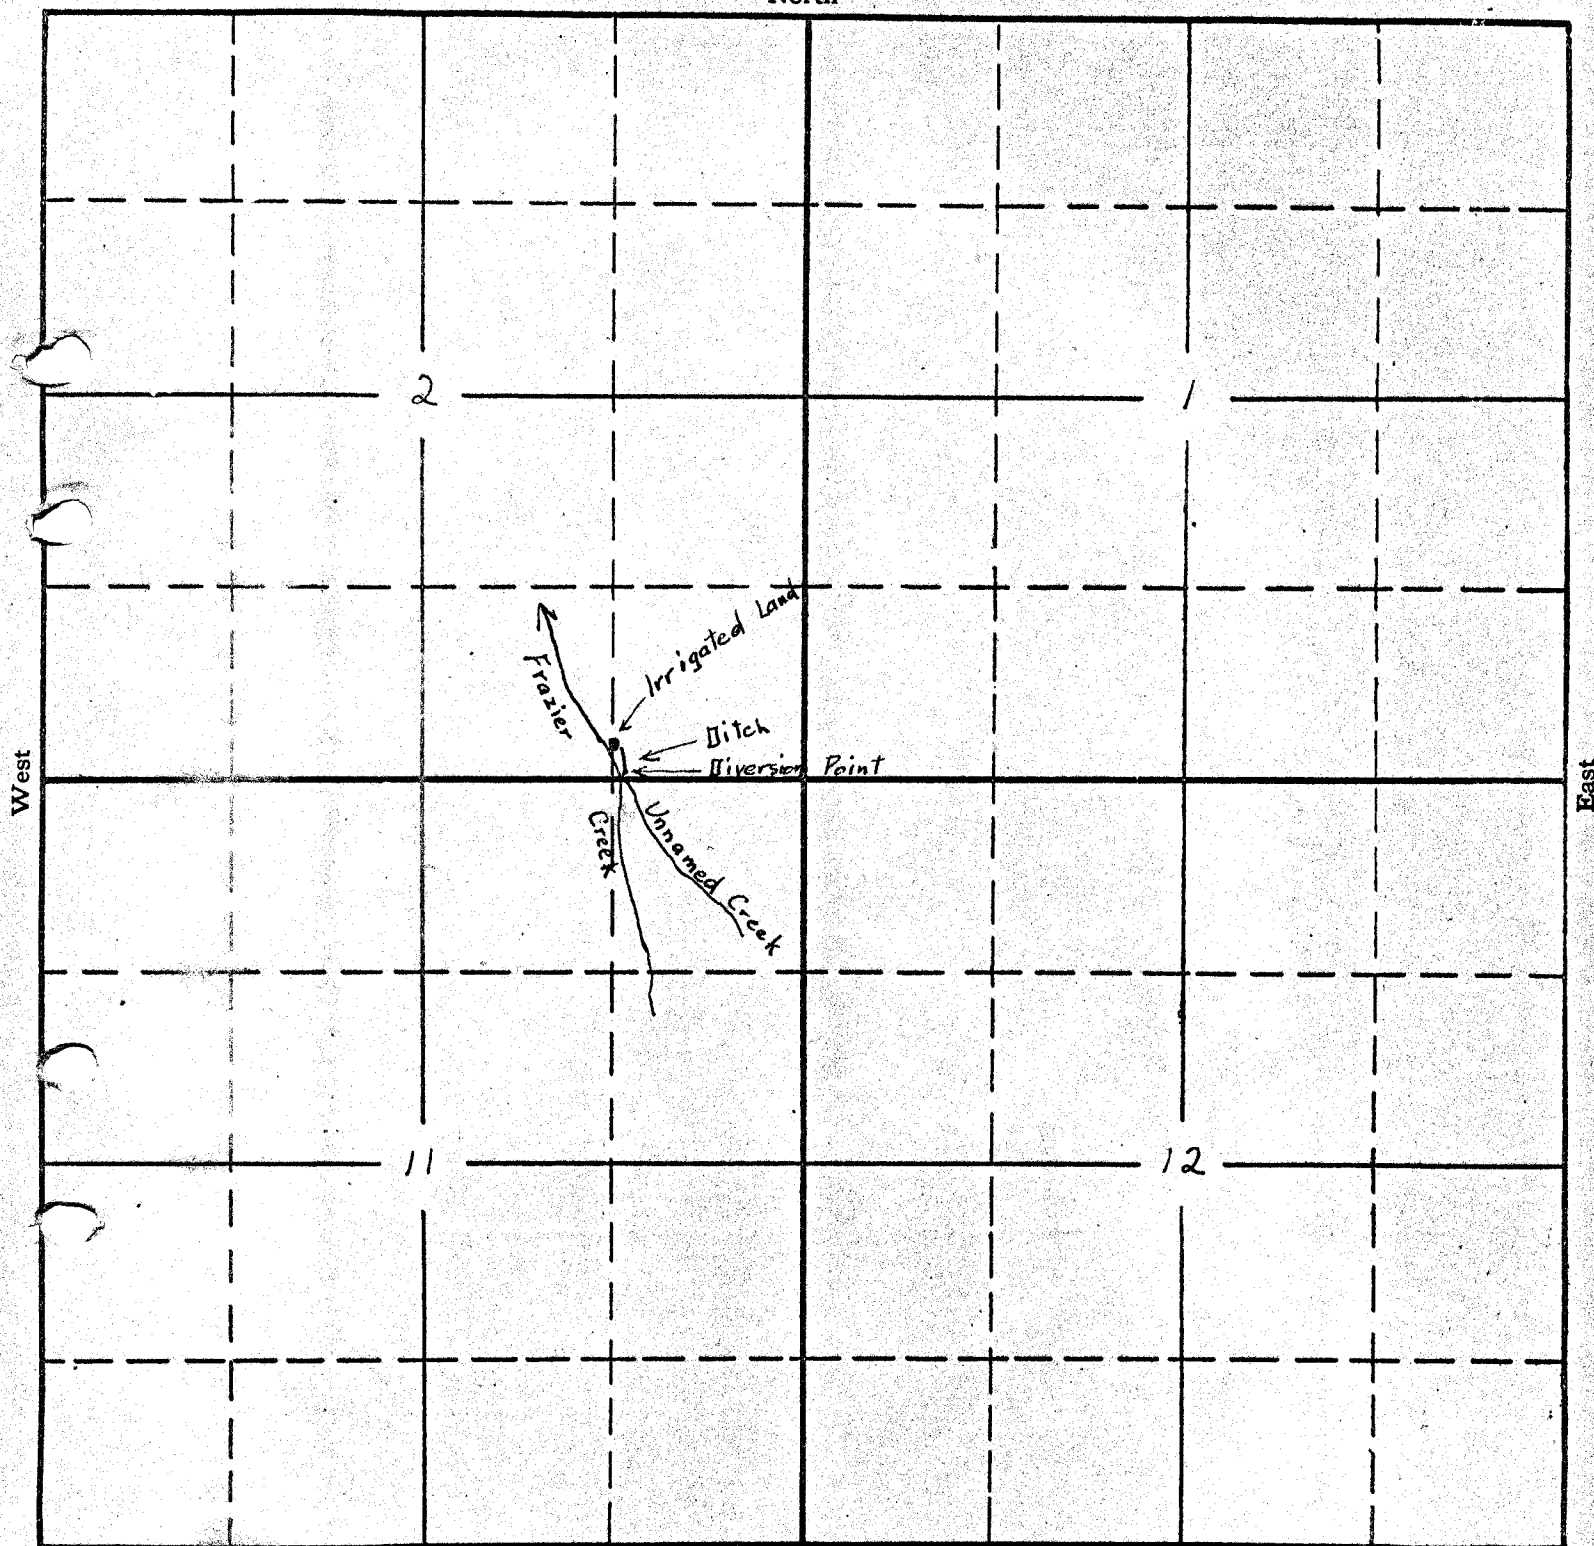

South

APPLICATION No. 14052

PERMIT No. 10137