




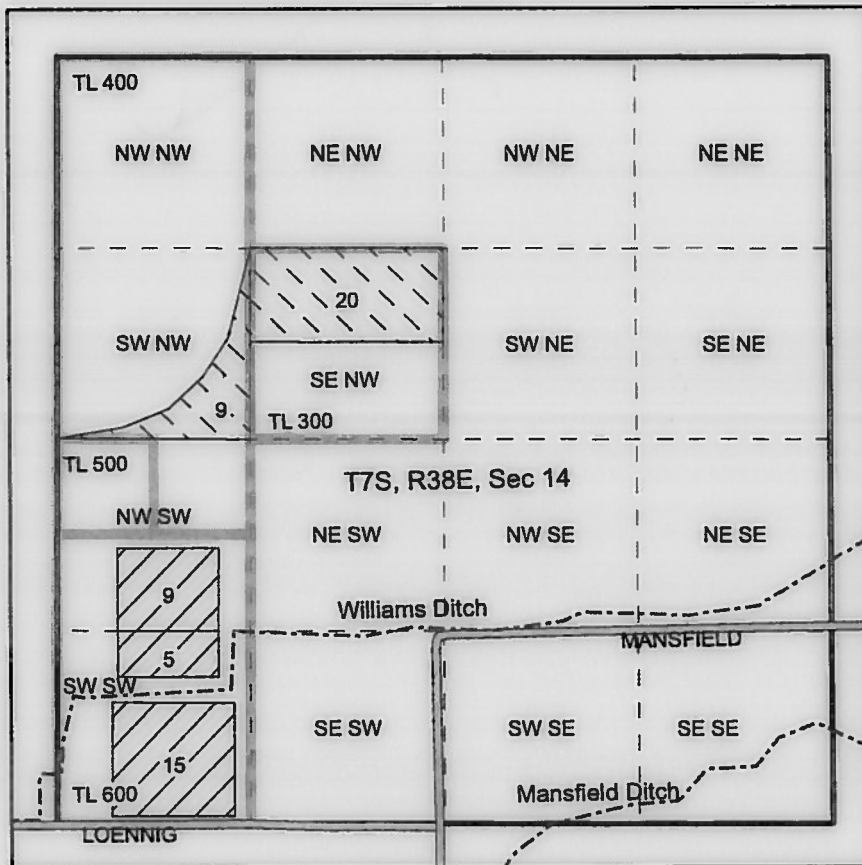


Results of T12555

- Priority 1881
- Priority 1893
- POD
- Ditch
- Stream
- Intermittent Stream
- Quarter quarter line
- Section line
- Tax lot lines

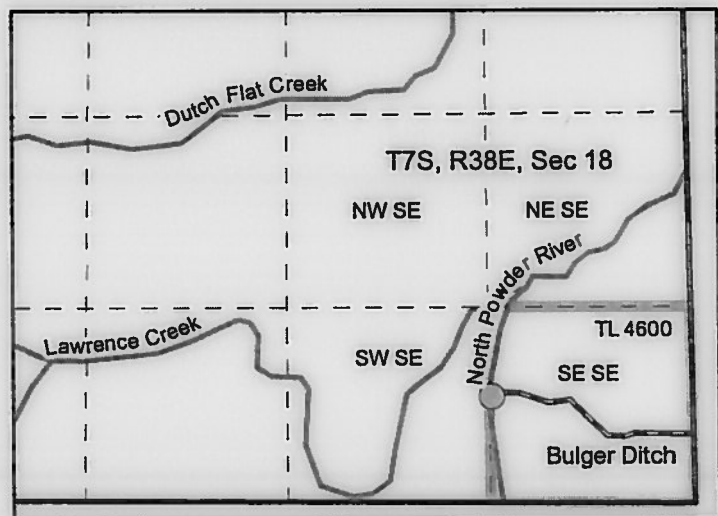

The POD is located in SW $\frac{1}{4}$ SE $\frac{1}{4}$, Section 18, T7S, R38E; 730 feet north and 1370 feet west from the SE corner

This map is not intended to provide legal dimensions or locations of property ownership lines.

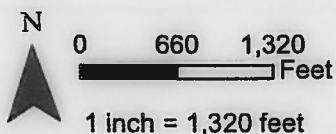

Final Proof Map Transfer T125555
Prepared for Roger W. and Linda M. Smith
Baker County
Tax Lots 300, 400, 500, and 600

Prepared by Nancy Rorick

Expires 12/3/2018