


# Claim of Beneficial Use Map, Transfer T-9230 (Permit G-6094) A Water Right in the Name of City of Mount Angel

RECEIVED  
SEP 08 2020

Marion County  
Township 6 South, Range 1 West (W.M.)

OWRD

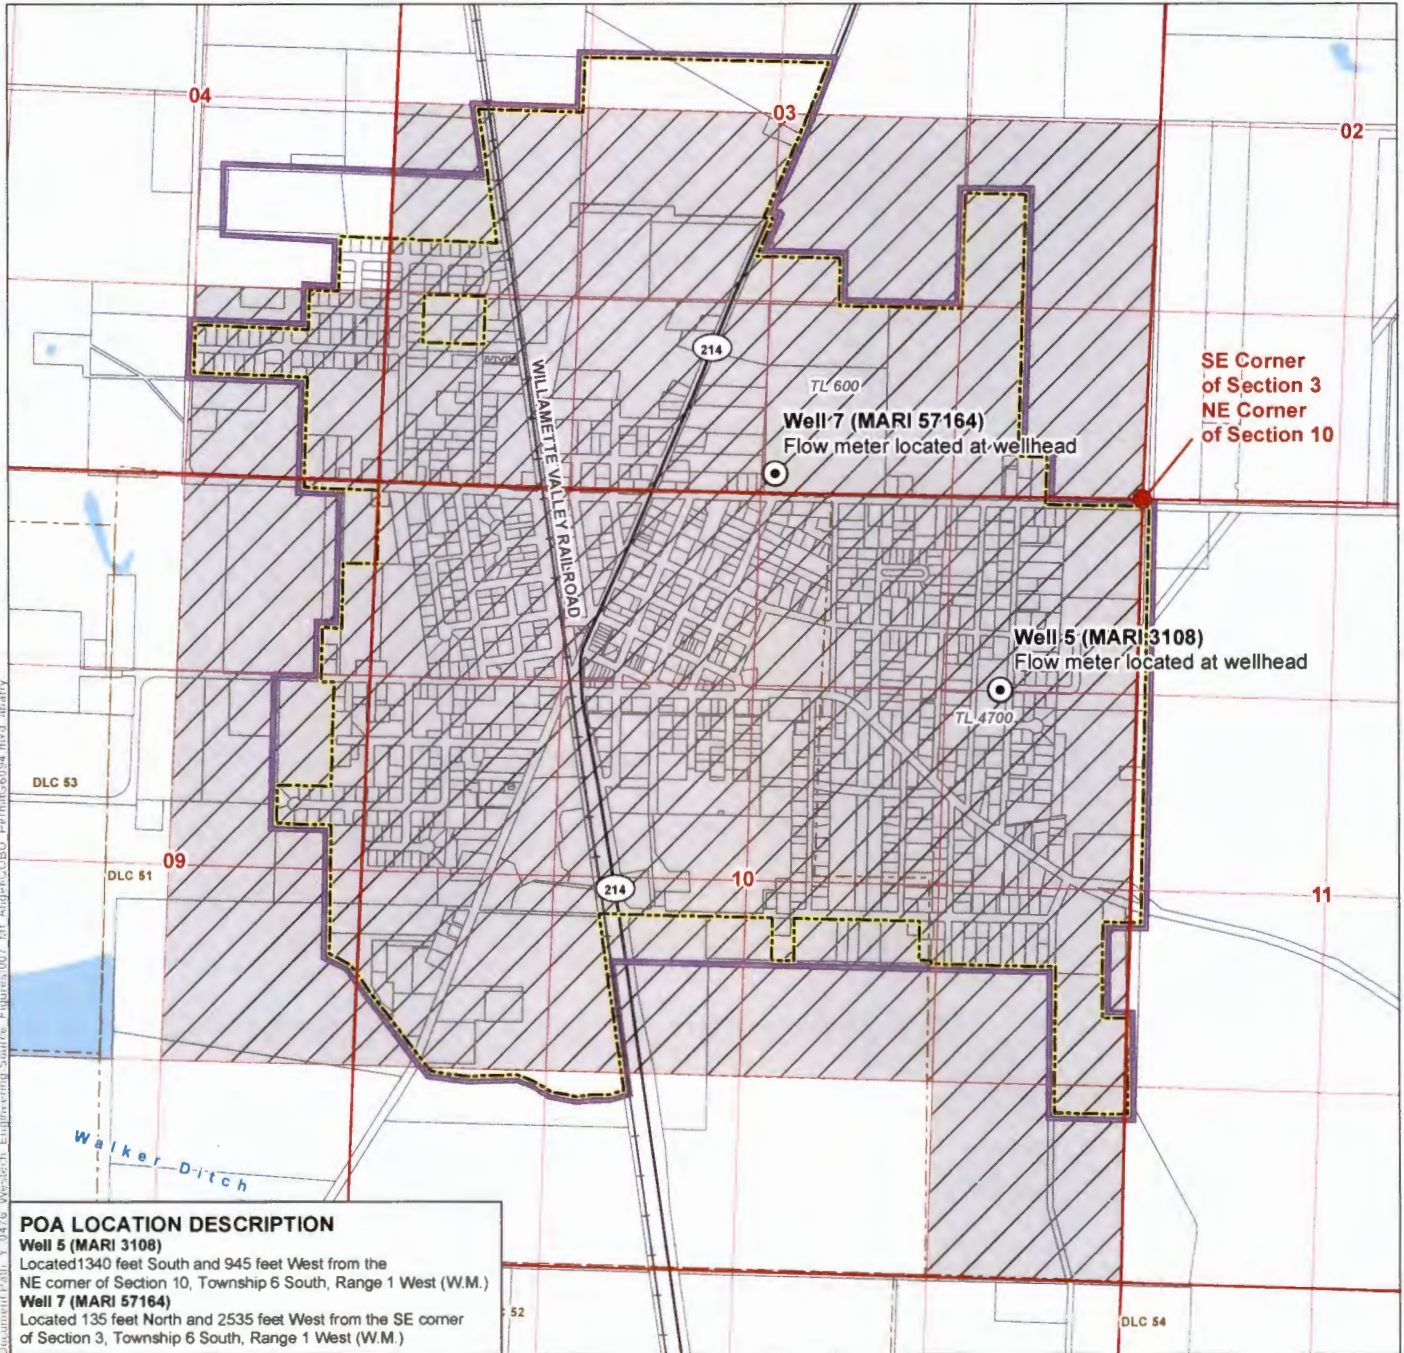

Document Path: Y:\0476\_Mount\_Angel\_Engineering\_Suites\_Figures\007\_Mt\_Angel\_CCBU\_PermitG6094.mxd - abatty

