



28 26

33 35

NW 83RD ST

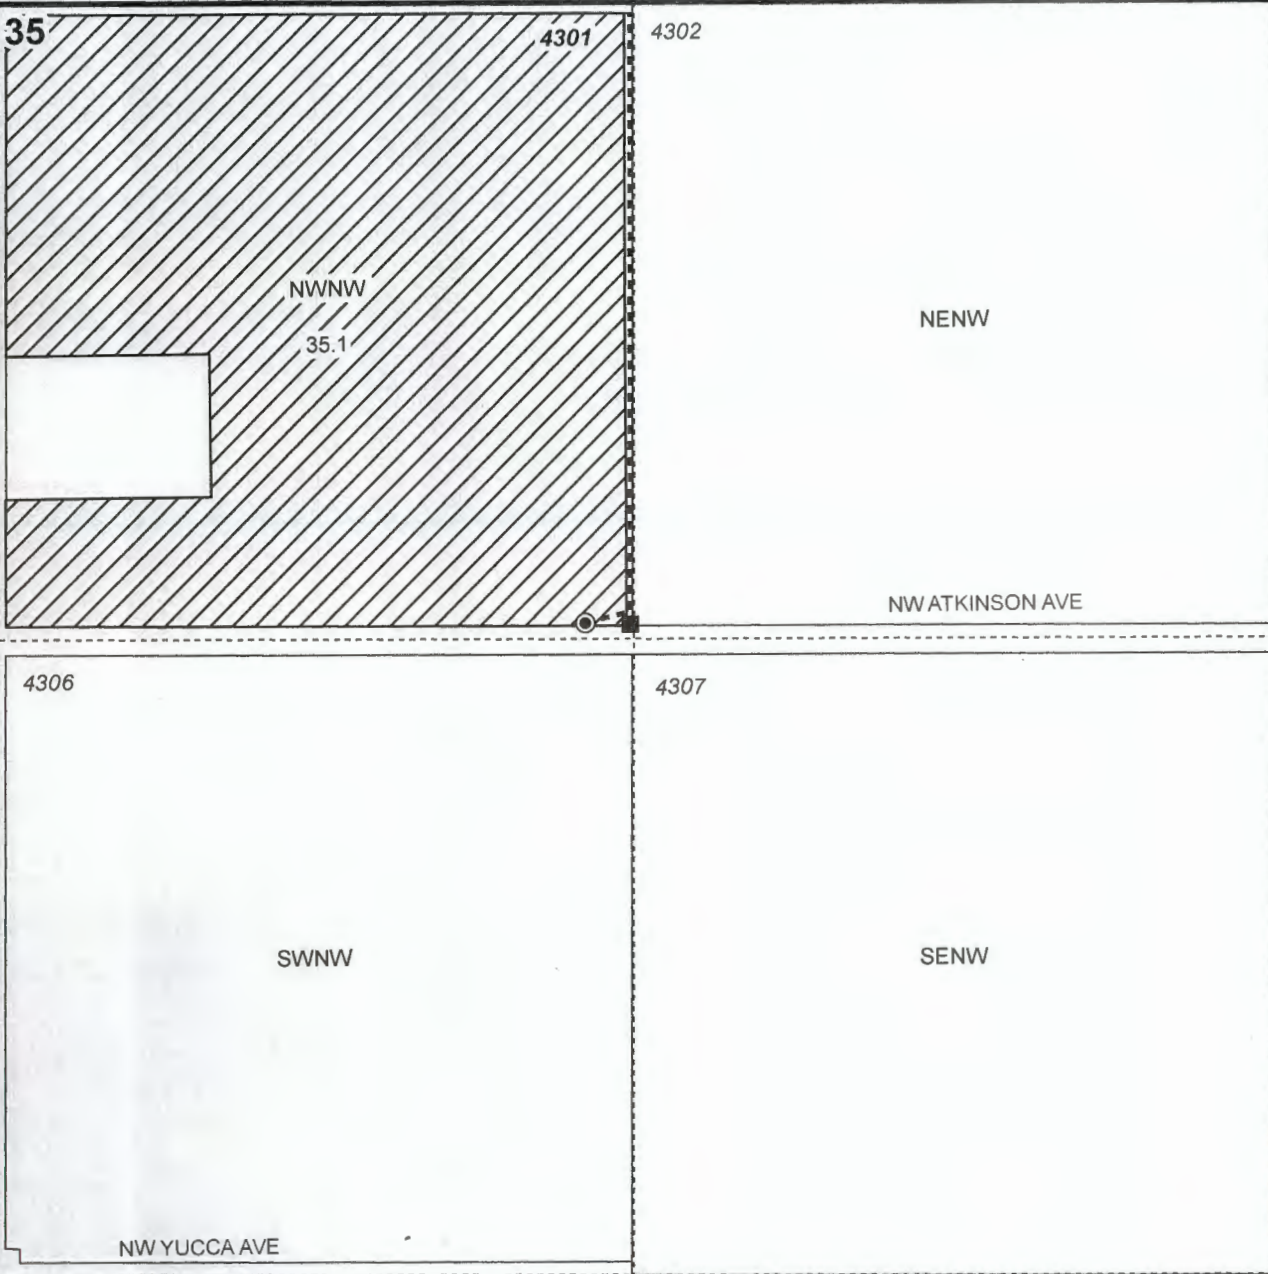

T14S R12E, WM
 DESCHUTES COUNTY, OREGON

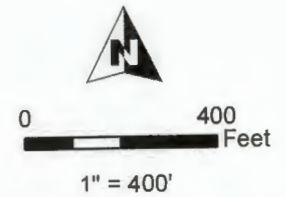

- POU Irrigation
- Section
- Quarter Quarter
- Taxlot
- Well
- Meter
- Mainline

RECEIVED
 NOV 13 2020
 OWRD

WELL LOCATION:
 35' N, 100' W OF SE COR, NWNW 1/4 1/4, SEC 35



RENEWAL DATE 12/31/2020

CLAIM OF BENEFICIAL USE
 Kristian and Heather Thordarson

NOTE: THIS MAP IS NOT INTENDED TO
 PROVIDE LEGAL DIMENSIONS OR LOCATIONS
 OF PROPERTY OWNERSHIP LINES.

WATER RIGHT SERVICES, LLC
 PO BOX 1830, BEND, OR 97709
 CCB# 197121 www.oregonwater.us
 541-389-2837 JOHNSHORT@USA.COM

AP G-16367

PERMIT G-16058

PROJECT #17009A

Date: 11/8/2020