



T16S R14E, WM,
CROOK COUNTY,
OREGON



- Well & Meter
- Pipeline
- ▨ POU IR
- Section
- Quarter Quarter
- Tax Lot

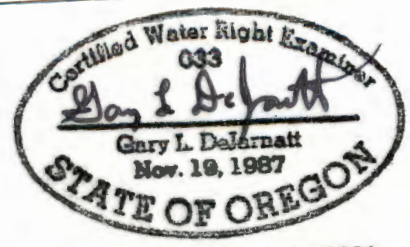

RENEWAL DATE 12/31/2021

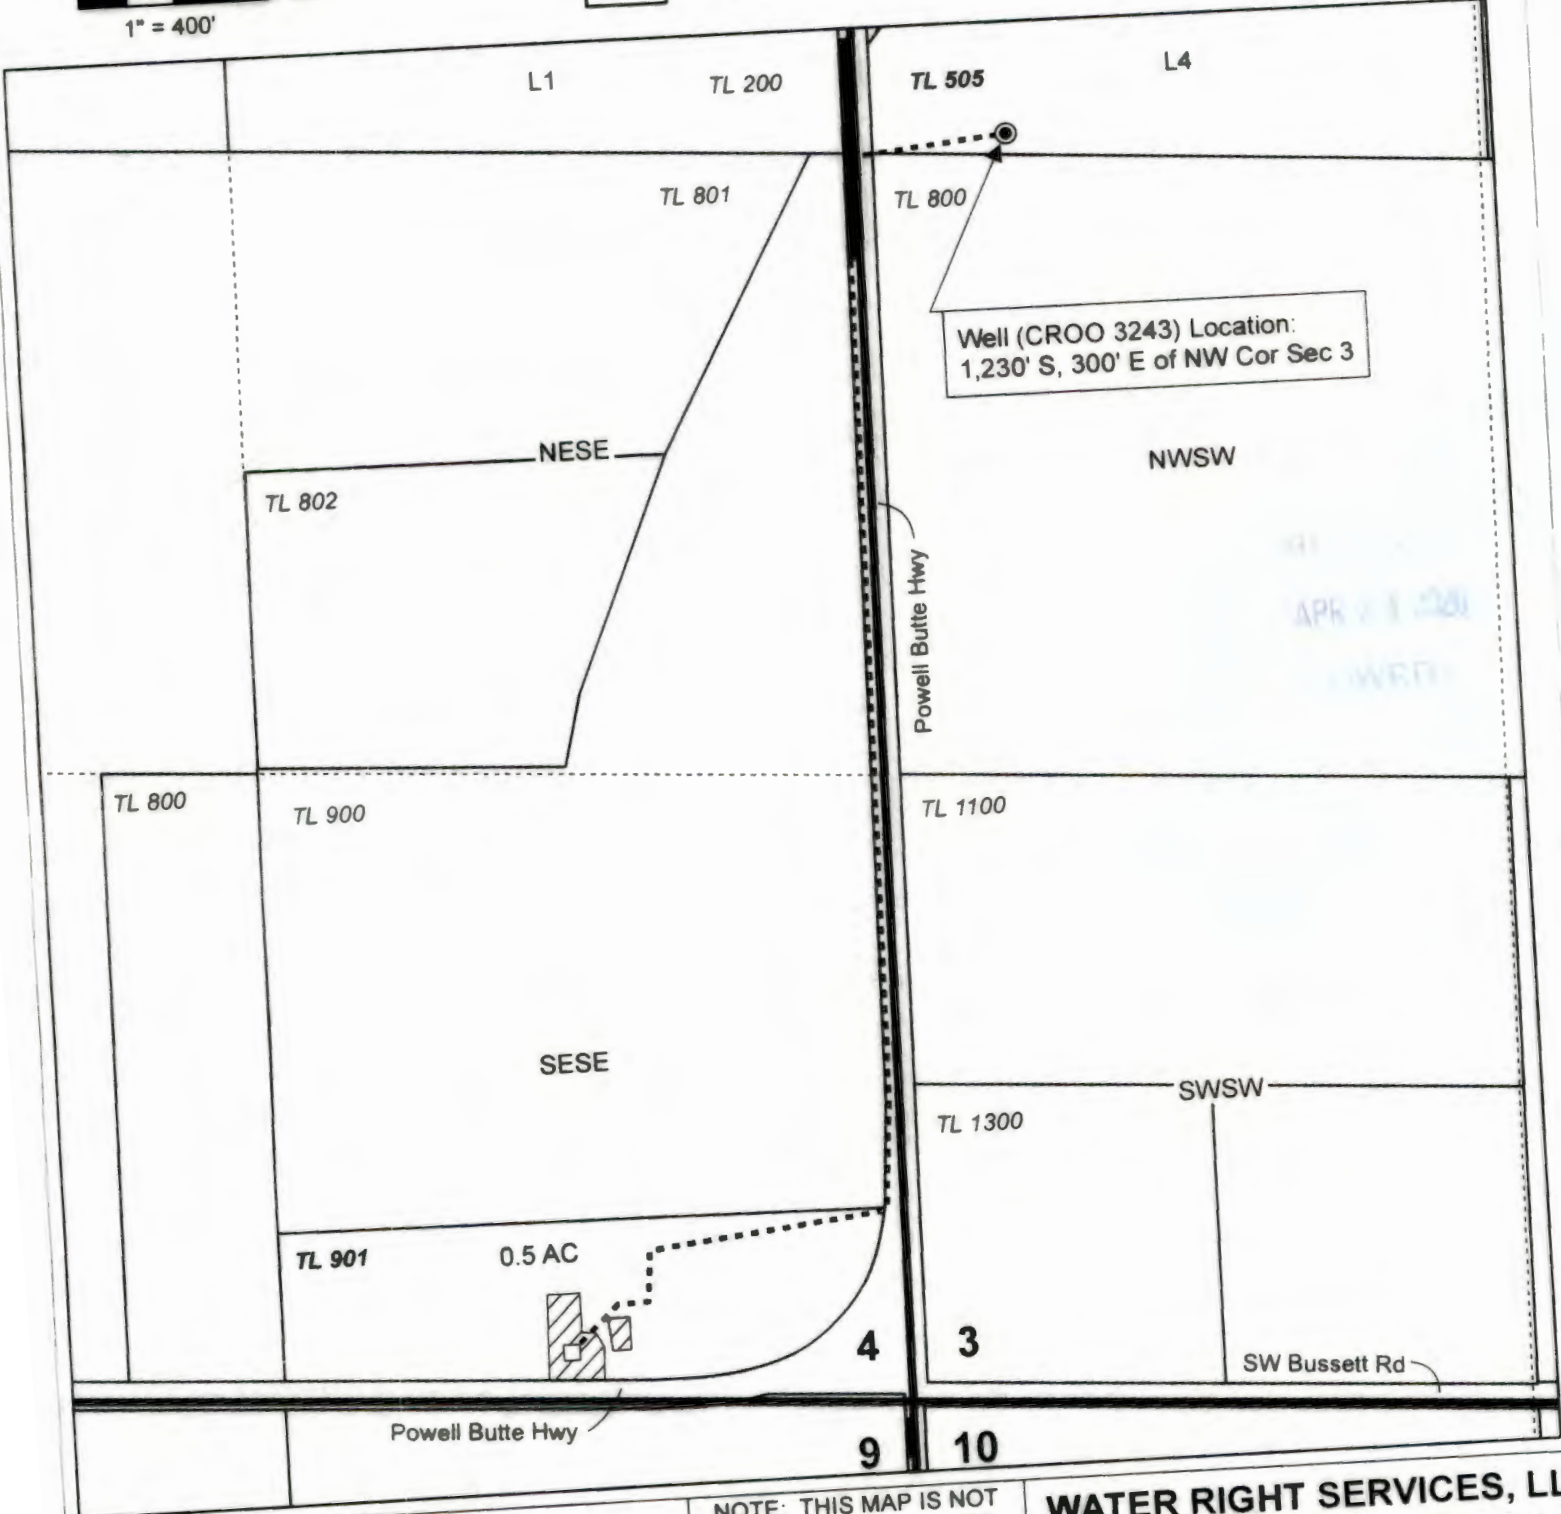

**PARTIAL CLAIM OF
BENEFICIAL USE MAP**

Anthony Dorsch, Brian Rost, & Jeff Rost
AP G-16483 PERMIT G-18244 JOB #19052

NOTE: THIS MAP IS NOT
INTENDED TO PROVIDE
LEGAL DIMENSIONS OR
LOCATIONS OF PROPERTY
OWNERSHIP LINES.
Date: 3/18/2020

WATER RIGHT SERVICES, LLC

PO BOX 1830, BEND, OR 97709
CCB# 197121 www.oregonwater.us
541-389-2837 JOHNSHORT@USA.COM