


# T.7S. R.2W. Sec. 2 & 3, W.M.

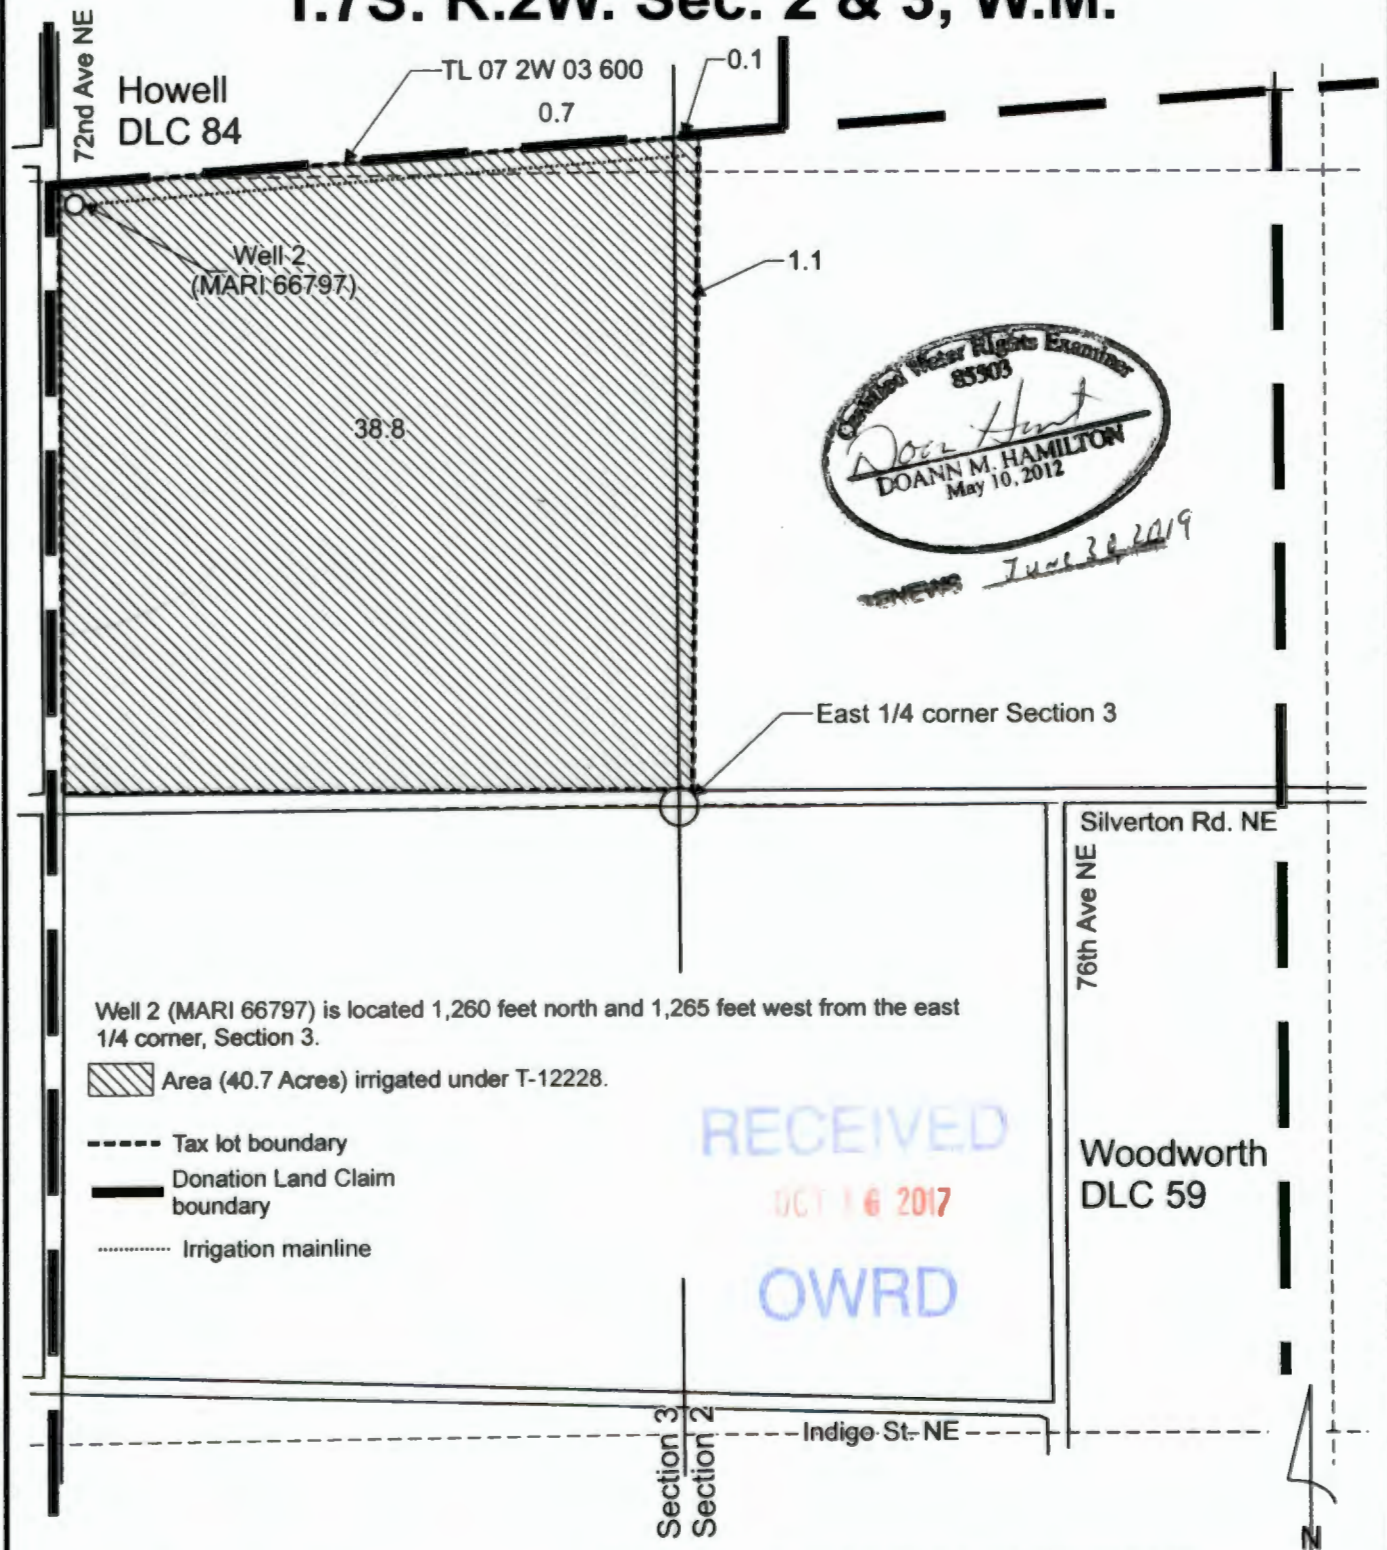


Well 2 (MARI 66797) is located 1,260 feet north and 1,265 feet west from the east 1/4 corner, Section 3.

Area (40.7 Acres) irrigated under T-12228.

- Tax lot boundary
- Donation Land Claim boundary
- Irrigation mainline

RECEIVED  
OCT 16 2017  
OWRD

Scale: 1" = 400'

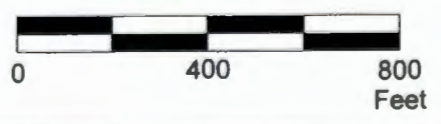

This map was prepared for the purpose of identifying the location of a water right only and is not intended to provide legal dimensions or location of property ownership lines.

Claim of Beneficial Use Map  
T-12228

Jim Roth  
T.7S. R.2W. Sec. 2 & 3, W.M.

Pacific Hydro-Geology Inc.

09/2017

RothCOBU.cdr