

Claim of Beneficial Use Map Points of Appropriation

Application G-13098, Permit G-18124, Permit Amendment T-11138
Deschutes County, Oregon
Township 17 South, Range 12 East (W.M.), Section 33



Document Path: Y:\0237_City_Band\Source_Figures\017_COBU_Report\Point_of_Appropriation_Pilot_Butte_3_4.mxd_wk\mxd

LEGEND


- Point of Appropriation (POA)
- Tax Lot
- Meter
- Major Road

POA LOCATION DESCRIPTION

Pilot Butte Well No. 3 (DESC 52907)
Located 145 feet North and 650 feet East from the SW corner of the NE1/4 NE1/4 of Section 33, Township 17 South, Range 12 East (W.M.)
Meter Location: Located in a vault outside of PB Well #1 pump house, 10 feet from East wall, and 215 feet WNW 282° from PB Well # 3

Pilot Butte Well No. 4 (DESC 58778)
Located 35 feet North and 128 feet East from the SW corner of the NE1/4 NE1/4 of Section 33, Township 17 South, Range 12 East (W.M.)
Meter Location: Located in a vault outside of the east wall of the pump house 20 feet from wall.

Certified Water Rights Examiner Stamp

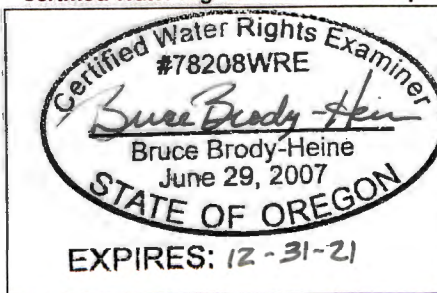


DISCLAIMER

This map was prepared for the purpose of identifying the location of a water right only and it is not intended to provide legal dimensions or location of property ownership lines.


MAP NOTES

Date: September 3, 2020
Data Sources: BLM, OGIC, City of Bend

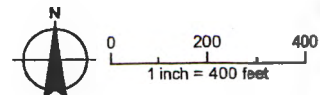



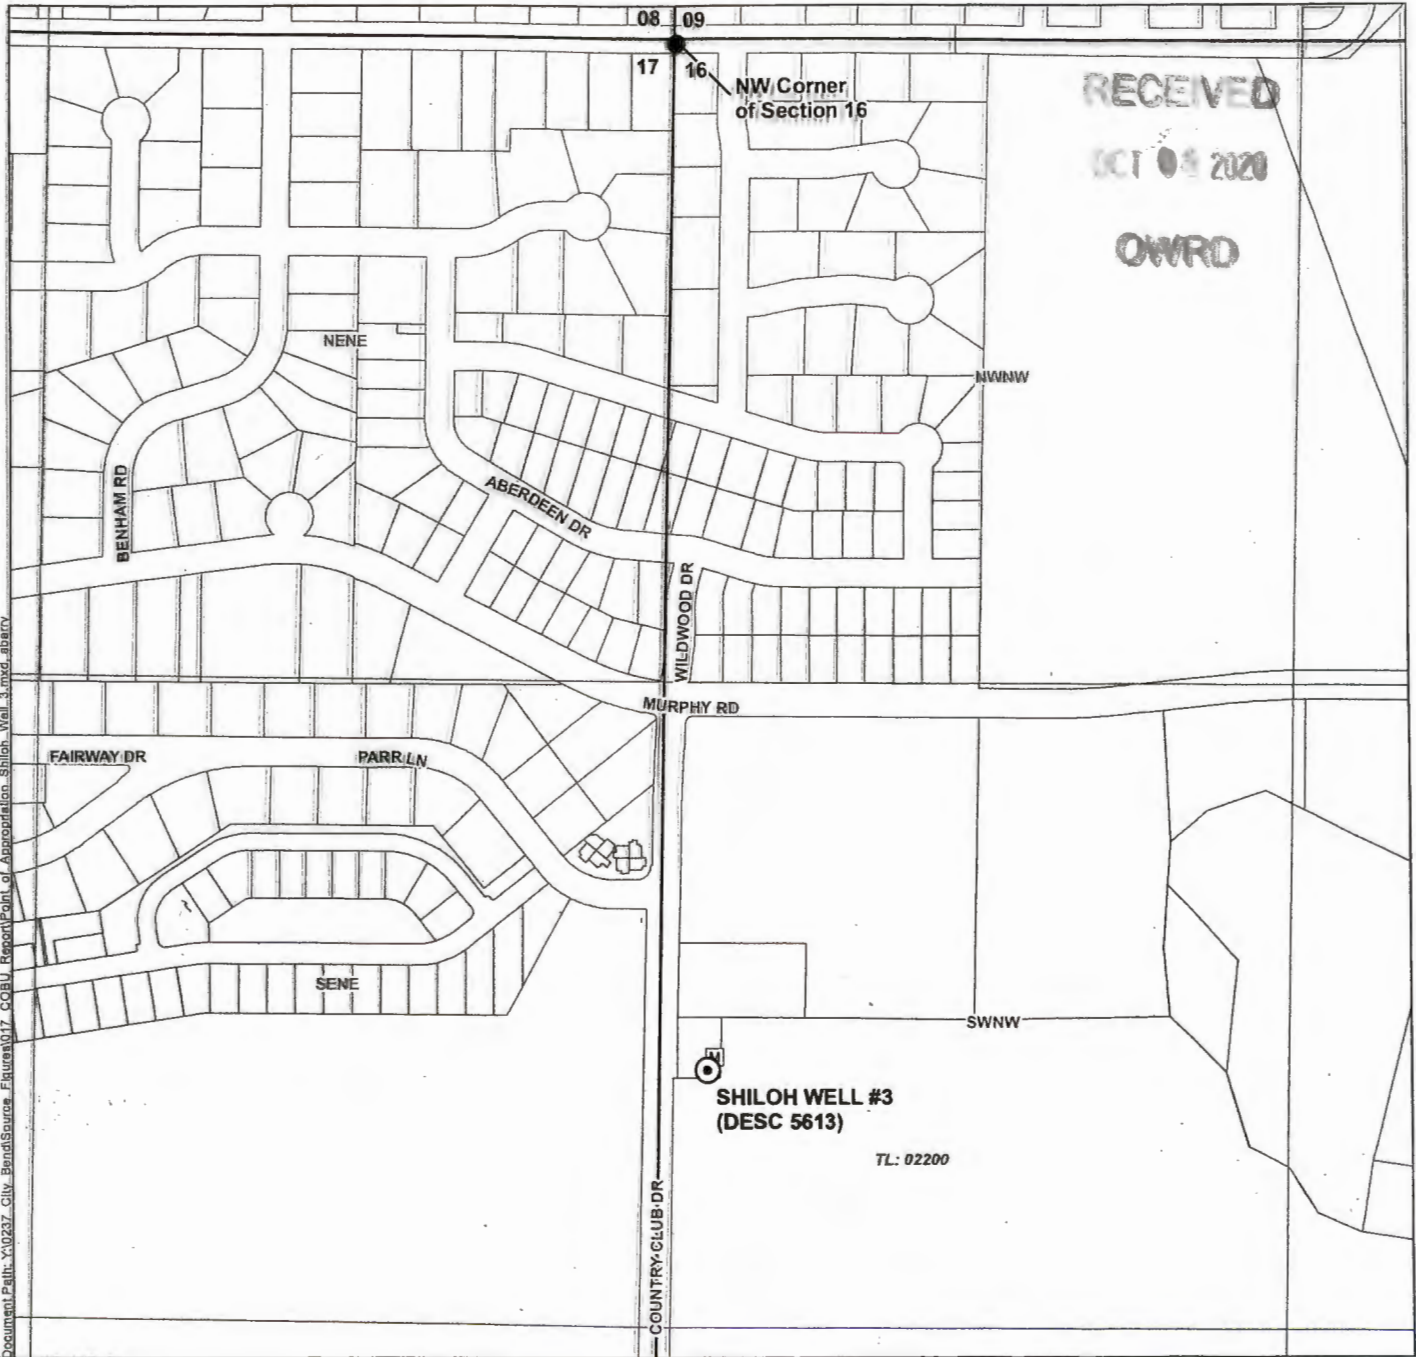

Claim of Beneficial Use Map Point of Appropriation

Application G-13098, Permit G-18124, Permit Amendment T-11138
Deschutes County, Oregon
Township 18 South, Range 12 East (W/M.), Section 16



Document Path: Y:\0237_City_Bend\Source_Figures\017_COBU_Report\Point_of_Appropriation_Shiloh_Well_3.mxd_abarty

LEGEND

-  Point of Appropriation (POA)
-  Tax Lot
-  Meter
-  Major Road

POA LOCATION DESCRIPTION
 Shiloh Well No. 3 (DESC 5613)
 Located South 1° 39' 08" East 2133 feet
 from the NW corner of Section 16,
 Township 18 South, Range 12 East (W.M.)
Meter Location: 10 feet from Wellhead
 inside pump house

Certified Water Rights Examiner Stamp




DISCLAIMER

This map was prepared for the purpose of identifying the location of a water right only and it is not intended to provide legal dimensions or location of property ownership lines.

MAP NOTES

Date: October 2, 2020
 Data Sources: BLM, OGIC,
 City of Bend

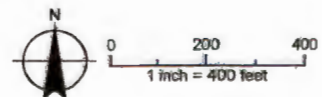


Claim of Beneficial Use Map Point of Appropriation

Application G-13098, Permit G-18124, Permit Amendment T-11138
Deschutes County, Oregon
Township 18 South, Range 11 East (W.M.), Section 3

RECEIVED



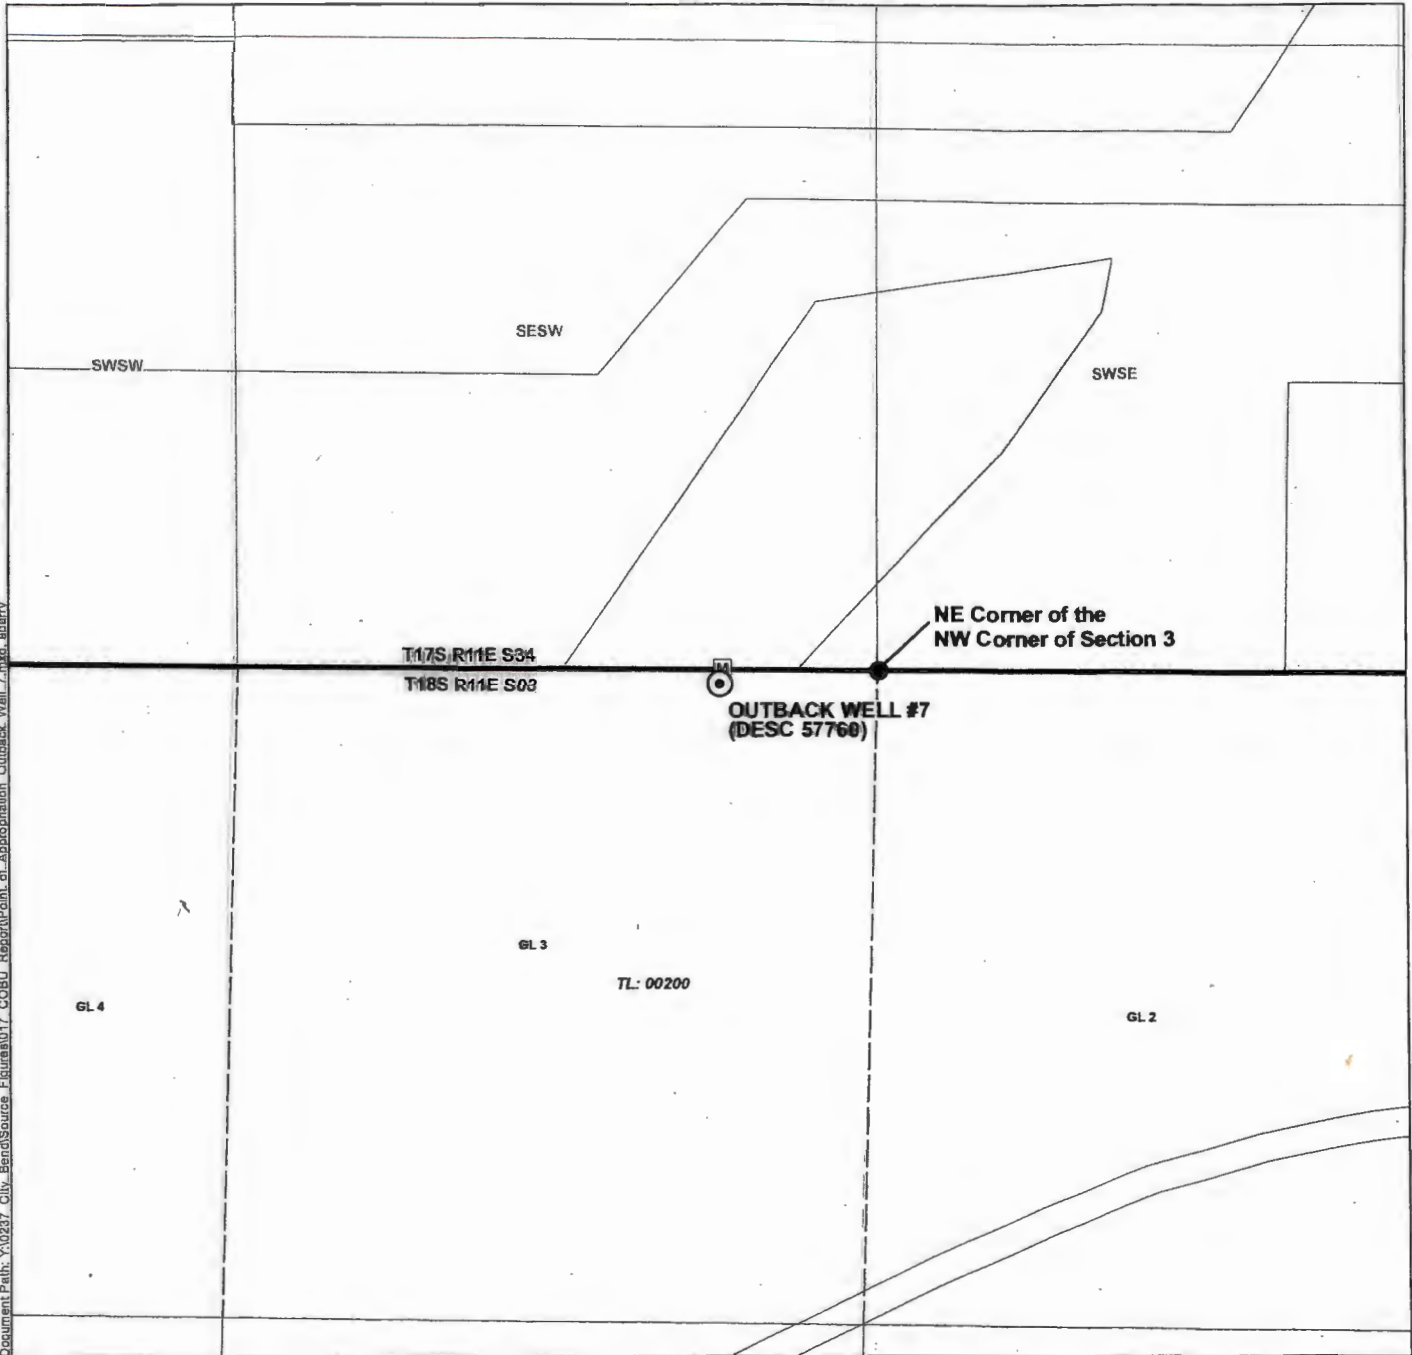


OCT 08 2020

OWIRD



Document Path: X:\0237_City_Bend\Source_Figures\017_COBU_Report\Point_of_Appropriation_Outback_Well_7.mxd_aharv

LEGEND

-  Point of Appropriation (POA)
-  Meter
-  Government Lot (GL)
-  Tax Lot
-  Major Road

POA LOCATION DESCRIPTION

Outback Well No. 7 (DESC 57760)
Located South 85° 37' 0.5" West 327.9 feet
from the NE corner of the NW quarter of Section 3,
Township 18 South, Range 11 East (W.M.)
Meter Location: Located in a vault outside of the
NE wall of pumphouse, 20' from wall.

Certified Water Rights Examiner Stamp




DISCLAIMER

This map was prepared for the purpose of identifying the location of a water right only and it is not intended to provide legal dimensions or location of property ownership lines.


MAP NOTES

Date: October 2, 2020
Data Sources: BLM, OGIC,
City of Bend

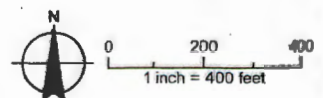





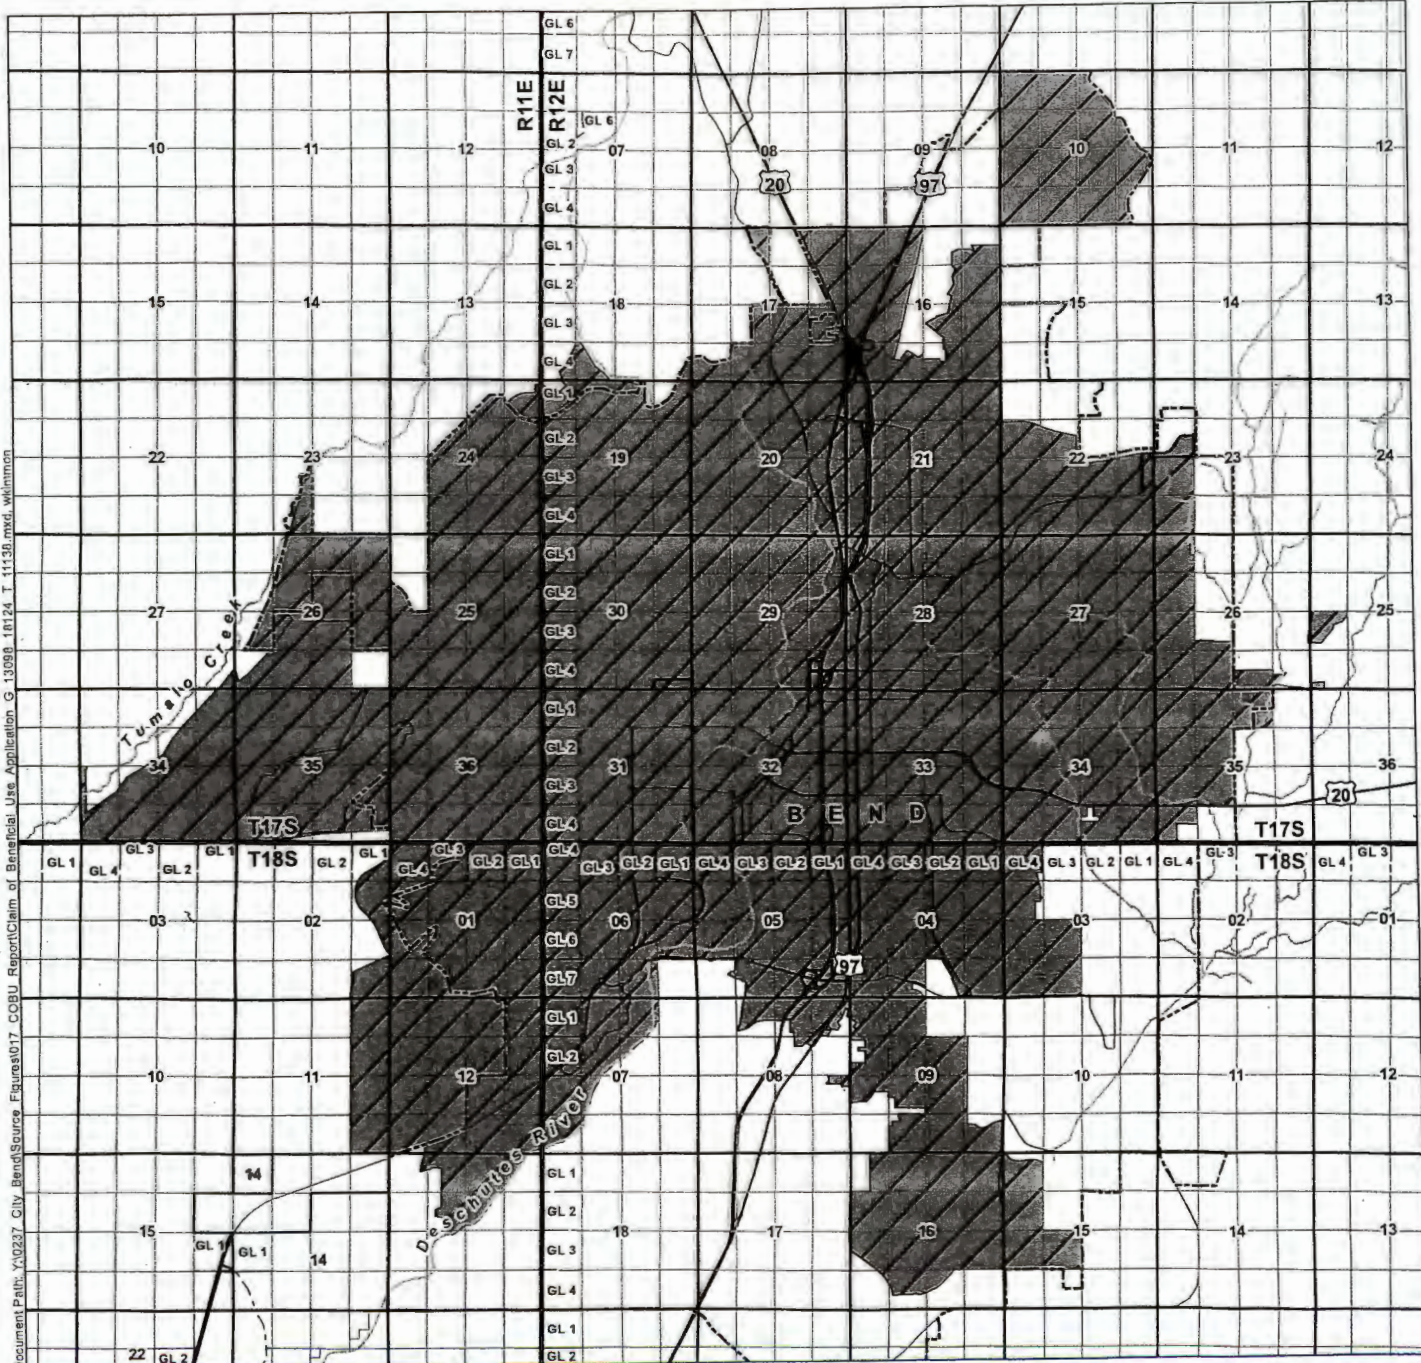

Claim of Beneficial Use Map Place of Use

Application G-13098, Permit G-18124, Permit Amendment T-11138
Deschutes County, Oregon
Township 17 and 18 South, Range 11 and 12 East (W.M.)




Document Path: Y:\0237_City_Bend\Source_Figures\017_COBU_Report\Claim of Beneficial Use_Application G_13098_18124_T_11138.mxd, wkmmmm

LEGEND

-  Place of Use (POU)
-  City Water Service Boundary
-  Government Lot (GL)
-  City Boundary
-  Major Road
-  Watercourse

Certified Water Rights Examiner Stamp

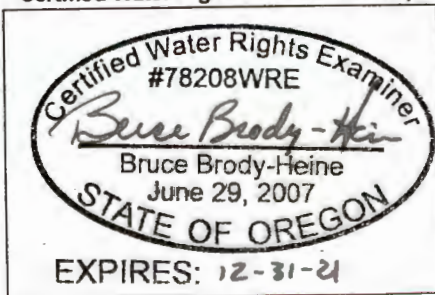


DISCLAIMER

This map was prepared for the purpose of identifying the location of a water right only and it is not intended to provide legal dimensions or location of property ownership lines.

MAP NOTES

Date: September 2, 2020
Data Sources: BLM, OGIC, City of Bend

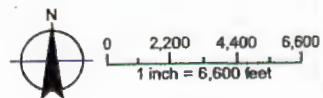

RECEIVED

SEP 2 2020

OWRO