


FINAL PROOF MAP

TO ADD POINTS OF APPROPRIATION AND PLACE OF USE FOR APPLICATION G-17002 BO THORENFELDT

TOWNSHIP 24 SOUTH, RANGE 32.5 EAST, SECTION 1, W.M.
TAX LOTS: 100, 200, 300, 600, 700, & 1100

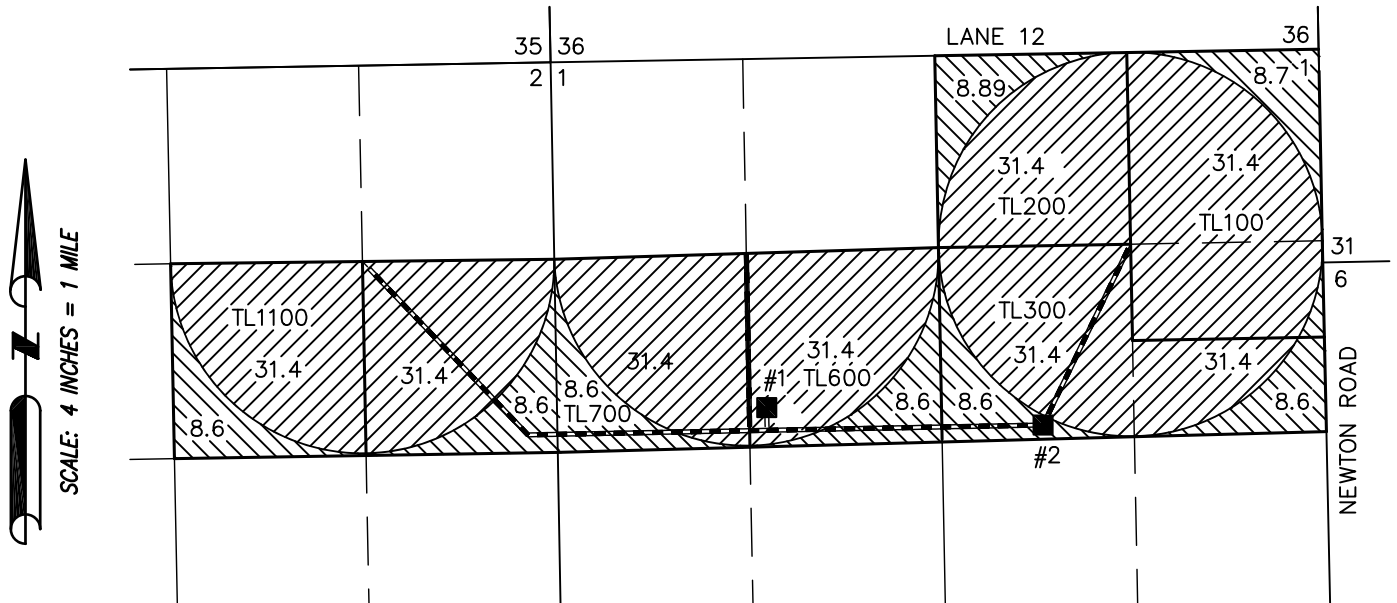

WELL 1 (HARN 52762)


LOCATED IN THE SE 1/4 OF THE NW 1/4 OF SECTION 1 AND 2400' SOUTH AND 1440' EAST FROM THE ASSUMED CORNER COMMON TO SECTIONS 35, 36, 1, AND 2.

FLOW METER IS LOCATED 4' SOUTH FROM WELL.

WELL 2 (HARN 52760)

LOCATED IN THE SW 1/4 OF THE NE 1/4 OF SECTION 1 AND 2550' SOUTH AND 3340' EAST FROM THE ASSUMED CORNER COMMON TO SECTIONS 35, 36, 1, AND 2.

FLOW METER IS LOCATED 7' NORTH FROM WELL.

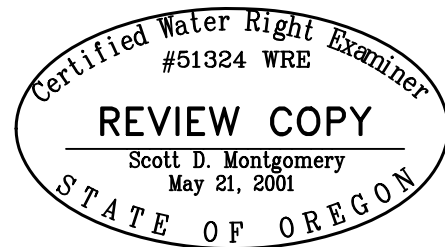

RENEWAL DATE: 12/31/2020

THIS MAP IS FOR THE PURPOSE OF LOCATING A WATER RIGHT ONLY AND HAS NO INTENT TO PROVIDE LEGAL DIMENSIONS OR THE LOCATION OF PROPERTY LINES

PREPARED FOR:

BO THORENFELDT
885 HILLSBOROUGH
HILLSBOROUGH, CA 94010

PREPARED BY:

ALL POINTS ENGINEERING AND SURVEYING, INC.
P.O. BOX 767 TERREBONNE, OR 97760
(541) 548-5833 www.APEandS.com