


FINAL PROOF MAP

TO ADD A POINT OF APPROPRIATION AND PLACE OF USE FOR APPLICATION G-17134 BO THORENFELDT

TOWNSHIP 23 SOUTH, RANGE 33 EAST, SECTION 32, W.M.
TAX LOTS: 100 & 200

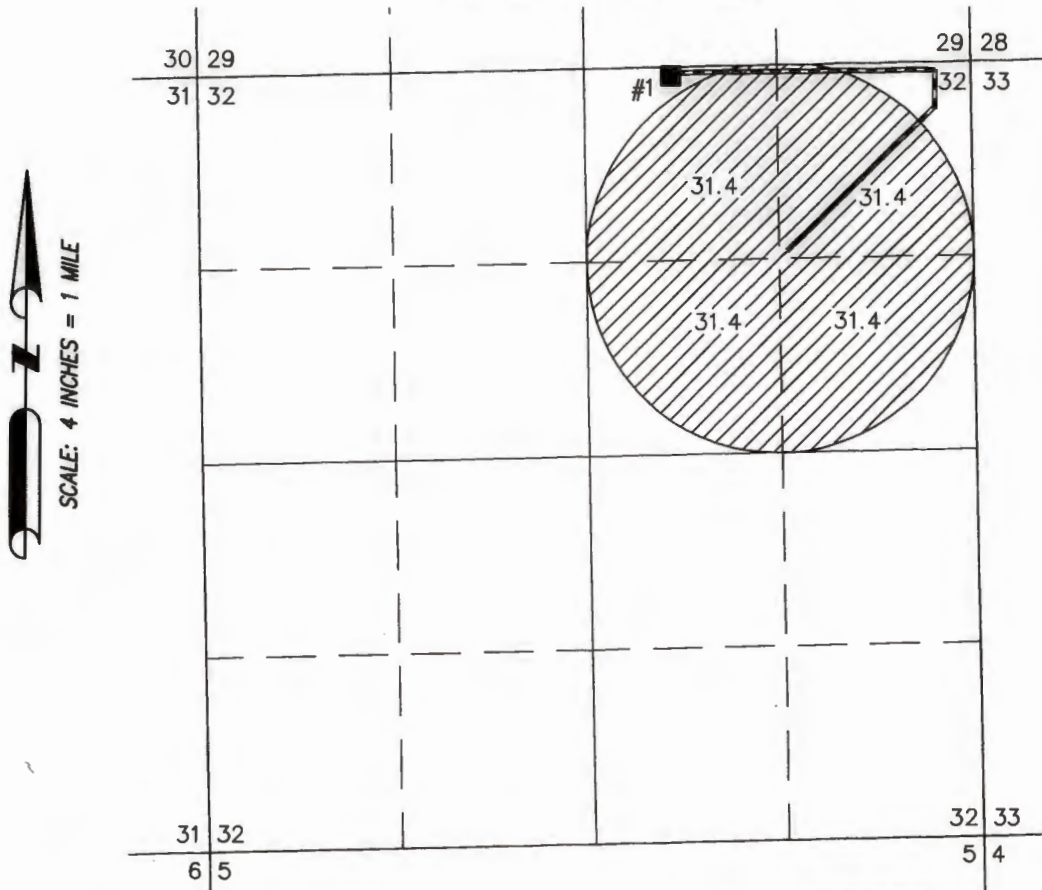

■ WELL 1 (HARN 52757)

LOCATED IN THE NW 1/4 OF THE NE 1/4 OF SECTION
32 WITH GEODETIC COORDINATES OF 43°32'10.7" NORTH
AND 118°40'36.5" WEST IN WGS84 PROJECTION.

FLOW METER IS LOCATED ON DELIVERY PIPE 4' NORTH
FROM WELL. ORIGINAL FLOW METER IS LOCATED 3'
EAST FROM THE CENTER PIVOT SPRINKLER.



RENEWAL DATE: 12/31/2020



125.6 ACRES WATER RIGHTS FROM WELL
PERMIT G-18252, AS SHOWN.

THIS MAP IS FOR THE PURPOSE OF LOCATING A WATER RIGHT
ONLY AND HAS NO INTENT TO PROVIDE LEGAL DIMENSIONS OR
THE LOCATION OF PROPERTY LINES

PREPARED FOR:

BO THORENFELDT
885 HILLSBOROUGH
HILLSBOROUGH, CA 94010

PREPARED BY:



ALL POINTS ENGINEERING AND SURVEYING, INC.
P.O. BOX 767
(541) 548-5833
TERREBONNE, OR 97760
www.APEandS.com