

**POA LOCATION DESCRIPTION**

**Riverdrive Well (POLK-51072/51184):** Located 2460 feet North and 2285 feet West of the SE Corner of Section 21, Township 8 South, Range 4 West (W.M.)  
 •Tax Lot: 204  
 •Flowmeter installed at wellhead.


**Polk Well 1 (POLK-2945/23):** Located 2455 feet North and 1815 feet West of the SE Corner of Section 21, Township 8 South, Range 4 West (W.M.)  
 •Tax Lot: 100  
 •Flowmeter installed at wellhead.

**Polk Well 2 (POLK-51438):** Located 2190 feet North and 2000 feet West of the SE Corner of Section 21, Township 8 South, Range 4 West (W.M.)  
 •Tax Lot: 100  
 •Flowmeter installed at wellhead.

**Polk Well 3 (POLK-52307):** Located 2005 feet North and 2120 feet West of the SE Corner of Section 21, Township 8 South, Range 4 West (W.M.)  
 •Tax Lot: 100  
 •Flowmeter installed at wellhead.

**DISCLAIMER**  
 This map was prepared for the purpose of identifying the location of a water right only and it is not intended to provide legal dimensions or location of property ownership lines.

- LEGEND**
- Point of Appropriation
  - Place of Use (POU) (within the Service Boundary of the City of Independence)
  - Donation Land Claim (DLC)
  - ⊕ Tax Lot
  - Railroad
  - ↗ Major Road
  - ~ Watercourse
  - Waterbody
- Date: May 15, 2020  
 Data Sources: OWRD, USGS, BLM, OGC, Polk Co.

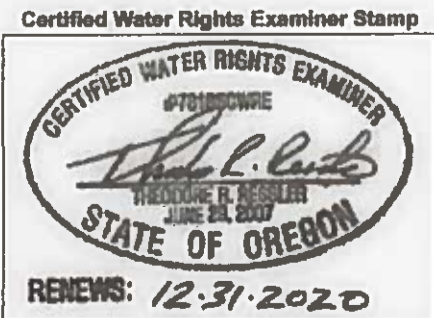


**RECEIVED**  
 AUG 12 2020

**OWRD**

**Claim of Beneficial Use**  
**Transfer T-10827**  
**A Water Right in the**  
**Name of City of Independence**

Polk County, Oregon  
 Township 8 South, Range 4 West (W.M.)

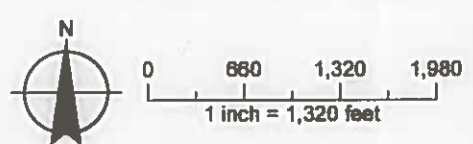

COBU MAR 1248