

POA LOCATION DESCRIPTION

Riverdrive Well (POLK-51072/51184): Located 2480 feet North and 2265 feet West of the SE Corner of Section 21, Township 8 South, Range 4 West (W.M.)
 •Tax Lot: 204
 •Flowmeter installed at wellhead.

Polk Well 1 (POLK-2945/23): Located 2455 feet North and 1815 feet West of the SE Corner of Section 21, Township 8 South, Range 4 West (W.M.)
 •Tax Lot: 100
 •Flowmeter installed at wellhead.


Polk Well 2 (POLK-51438): Located 2190 feet North and 2000 feet West of the SE Corner of Section 21, Township 8 South, Range 4 West (W.M.)
 •Tax Lot: 100
 •Flowmeter installed at wellhead.

Polk Well 3 (POLK-52307): Located 2005 feet North and 2120 feet West of the SE Corner of Section 21, Township 8 South, Range 4 West (W.M.)
 •Tax Lot: 100
 •Flowmeter installed at wellhead.

DISCLAIMER
 This map was prepared for the purpose of identifying the location of a water right only and it is not intended to provide legal dimensions or location of property ownership lines.

LEGEND


- ⊙ Point of Appropriation (POA)
 - Place of Use (POU) (within the Urban Growth Boundary of the City of Independence)
 - Donation Land Claim (DLC)
 - ⊕ Tax Lot
 - Railroad
 - Major Road
 - ~ Watercourse
 - Waterbody
- Date: May 15, 2020
 Data Sources: OWRD, USGS, BLM, OGIS, Polk Co.

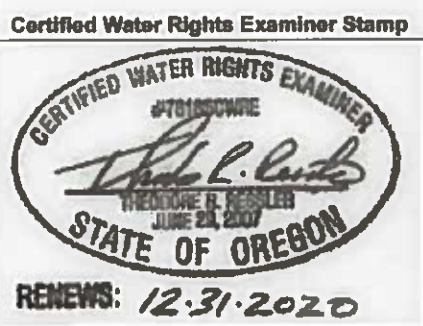

RECEIVED
 AUG 12 2020

Claim of Beneficial Use
Transfer T-12261
A Water Right in the
Name of City of Independence

OWRD Polk County, Oregon
 Township 8 South, Range 4 West (W.M.)

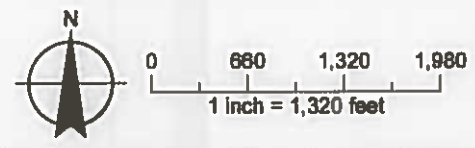

COBU MAP # 1249