


CLAIM OF BENEFICIAL USE

TRANSFER T-11726

SECTION 8, T 40 S, R 3 W, WM. JACKSON COUNTY, OREGON

Jackson County Oregon

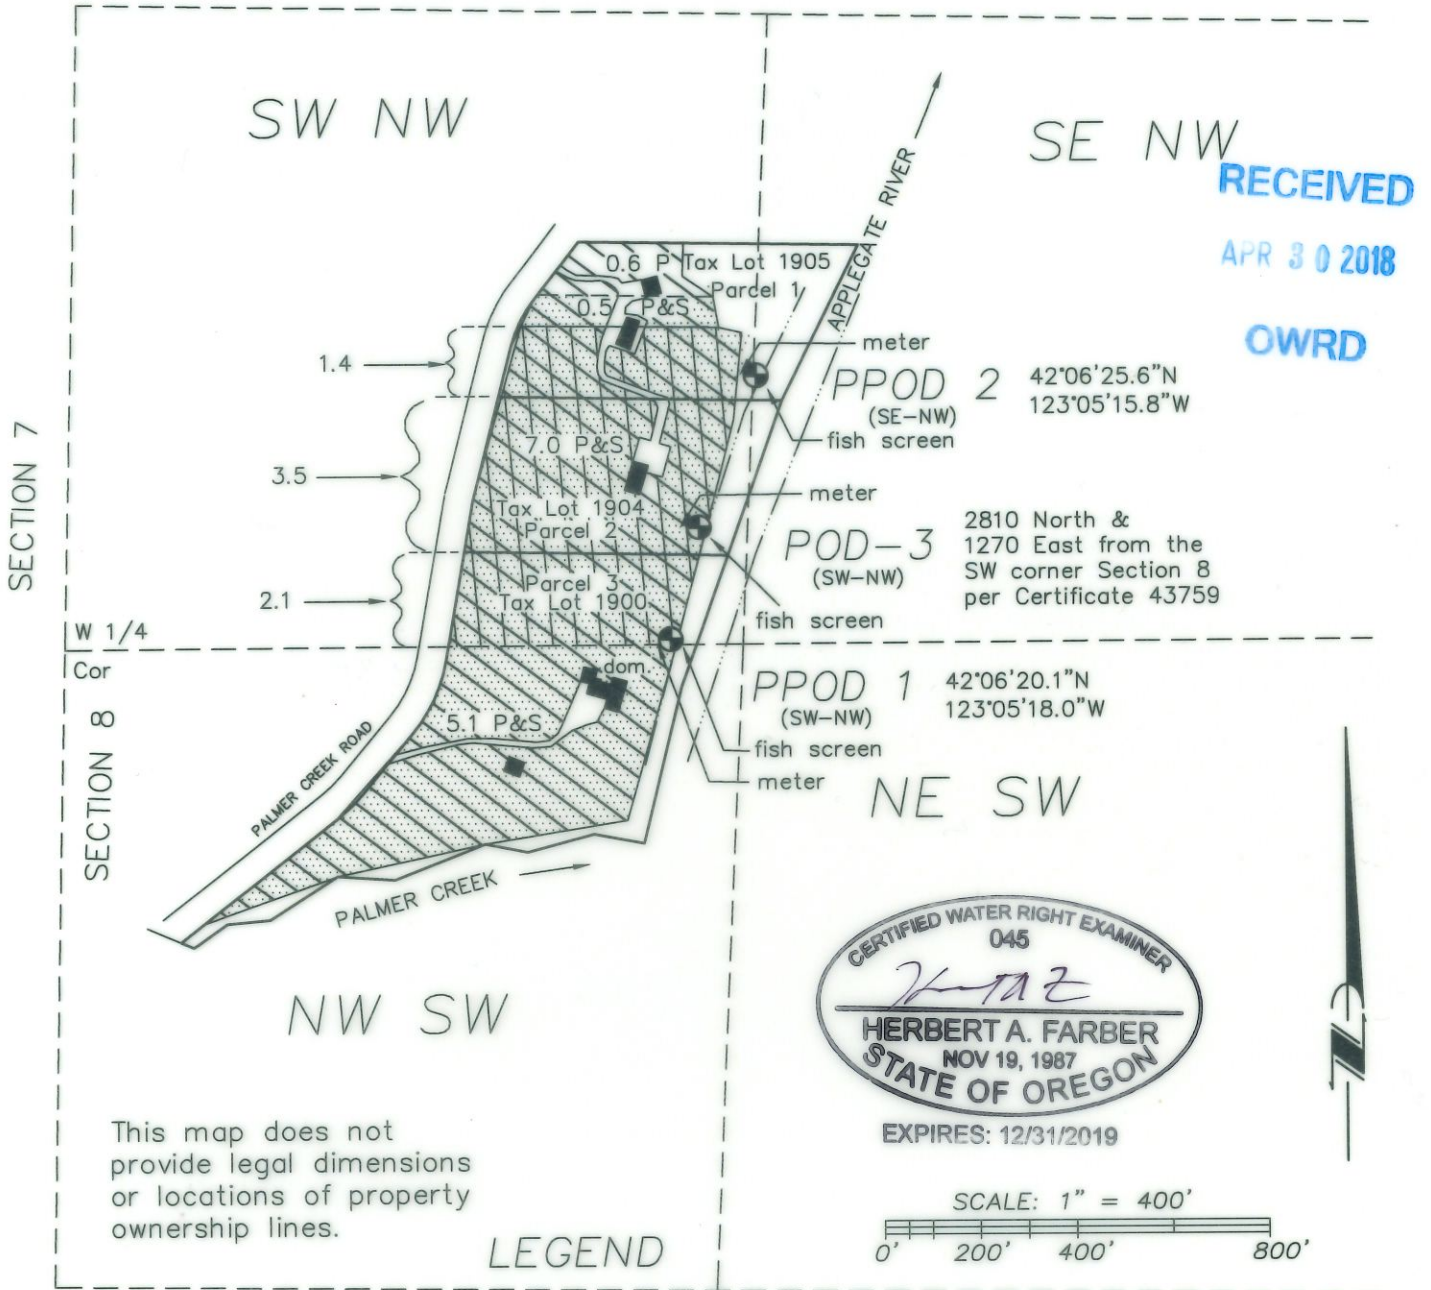

= PRIMARY CONTAINING 7.0 ACRES Certificate 19687, Priority Date April 7, 1947



= PRIMARY CONTAINING 6.2 ACRES Certificate 43759, Priority Date July 19, 1957

= SUPPLEMENTAL CONTAINING 7.0 ACRES Certificate 43759 Priority Date July 19, 1957



= SUPPLEMENTAL CONTAINING 12.6 ACRES Certificate 57255, Priority Date July 27, 1981

SW/NW	NW/SW	
7.0(p)	domestic	Cert-19687
7.0(s) 1.1(p)	5.1(p)	Cert-43759
7.5(s)	5.1(s)	Cert-57255

TAX LOT 1905-2.5 ACRES IRRIGATED, 1.1(P) & 1.4(S) ACRES CERTIFICATE 43759, 1.9(S) ACRES CERTIFICATE 57255 AND 1.4(P) ACRES CERTIFICATE 19687. (Avery)

TAX LOT 1904-3.5 ACRES IRRIGATED CERTIFICATE 19687(P), 43759(S) & 57255(S). (Avery)

TAX LOT 1900-2.1 ACRES IRRIGATED IN SW NW CERTIFICATE 19687(P), 43759(S) & 57584(S). 5.1 ACRES IRRIGATED CERTIFICATE 43759(P) & 57255(S) IN NW SW FOR A TOTAL OF 7.2 ACRES. (Staver)

Prepared for:

Ralph L. Staver
Wade & Colleen Avery

Prepared by:

FARBER & SONS, INC.
dba FARBER SURVEYING
(541) 664-5599

PO BOX 5286
431 OAK STREET
CENTRAL POINT, OREGON 97502

DATE: April 12, 2018 n.e.d.
JOB NO. 1671-09