


T.1S. R.4E. Section 35, W.M.

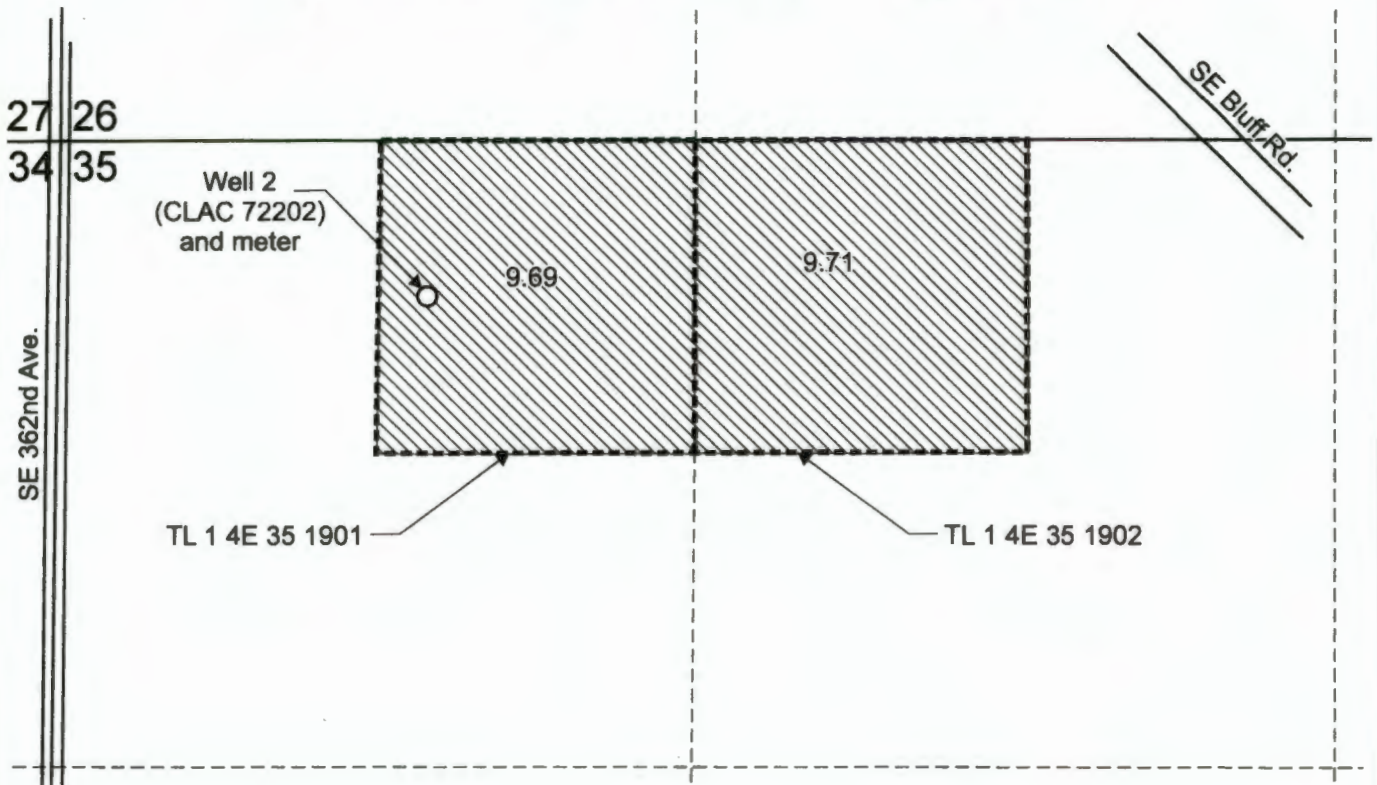

Well 2 (CLAC 72202) is located 330 feet south and 730 feet east from the NW corner, Section 35.

 Area (19.40 Acres) irrigated under T-12167.

----- Tax lot boundary

RECEIVE


1 2 - 4.8

OWRI



RECEIVED JUN 30 2019

Scale: 1" = 400'

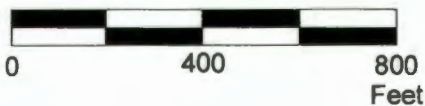

This map was prepared for the purpose of identifying the location of a water right only and is not intended to provide legal dimensions or location of property ownership lines.



Claim of Beneficial Use Map
T-12167

Troutner Farms, LLC c/o Brian Troutner
T.1S. R.4E. Section 35, W.M.

Pacific Hydro-Geology Inc.

04/2018